

WASH.
JD 144
5-8-74

MISSISSIPPI
BOARD OF WATER COMMISSIONERS
416 North State Street
Jackson, Mississippi 39201
WATER WELL DRILLERS LOG

CODED

May 8 1974 Singer-Layne Central Div. Washington
date well completed firm name county well located


LANDOWNER:	description of formations encountered	from	to
Tuffnut Planting Company, Inc.			
Greenville, Mississippi (mailing address)	Coarse Sand	12	30
	Coarse Sand	30	84
	Clay	84	85
WELL LOCATION:			
sec. 27 T. 18 N. R. 8 E. = =5 W			
_____ miles _____ of Greenville (distance) (direction) (nearest town)			
WELL PURPOSE: Irrigation (home, irrigation, municipal, industrial)			
WELL COMPLETION DATA:			
(1) diameter (inches) 16"	CODED		
(2) total depth (feet) 84'			
(3) static water level (feet) 7 below top of ground.			
(4) casing Steel, 54' (material) (depth) 16" If telescope see back. (size)			
(5) screen 30', 84' (length) (depth to top) 16", Armco Iron (size) (material)			
(6) pump _____ (HP) _____ (yield gpm) (type power)			
(7) electric log No (yes or no) (organization running log)			
(8) how well bottom plugged Plate			
DRILLERS REMARKS:			
Purchaser's pumping equipment to be used.			

RECEIVED
JUN 20 1974

MISS. BD. OF WATER COMMISSIONERS

If well telescopes please sketch and show depths.

GROUND LEVEL

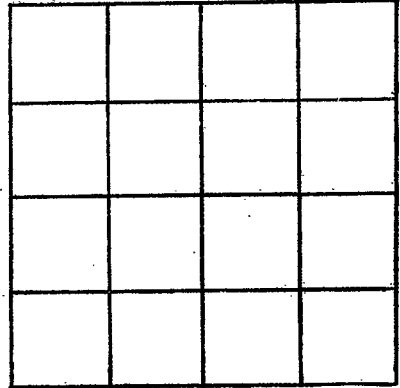

SECTION _____

Please indicate well location X.

ADDITIONAL INFORMATION

If more than one screen, show locations of each on sketch.