

WASH.
D 145
5-11-74

MISSISSIPPI
BOARD OF WATER COMMISSIONERS
416 North State Street
Jackson, Mississippi 39201

CODED

WATER WELL DRILLERS LOG

May 11 1974 Singer-Layne Central Div. Washington
date well completed firm name county well located


| LANDOWNER: | description of formations encountered | from | to |
|--|---------------------------------------|------|----|
| Tuffnut Planting Company, Inc. Greenville, Mississippi (mailing address) | | | |
| | Coarse Sand | 12 | 30 |
| | Coarse Sand | 30 | 82 |
| | Clay | 82 | 83 |
| WELL LOCATION: | | | |
| sec. 27 T 18 N R 8 E =S= W | | | |
| _____ miles _____ of Greenville (distance) (direction) (nearest town) | | | |
| WELL PURPOSE: Irrigation (home, irrigation, municipal, industrial) | | | |
| WELL COMPLETION DATA: | | | |
| (1) diameter (inches) 16" | CODED | | |
| (2) total depth (feet) 82' | | | |
| (3) static water level (feet) 7 below top of ground. above | | | |
| (4) casing Steel 52' (material) (depth) 16" If telescope see back. (size) | | | |
| (5) screen 30' 82' (length) (depth to top) 16" Armco Iron (size) (material) | | | |
| (6) pump _____ (HP) _____ (yield gpm) (type power) | | | |
| (7) electric log No (yes or no) | | | |
| (organization running log) | | | |
| (8) how well bottom plugged Plate | | | |
| DRILLERS REMARKS: | | | |
| Purchaser's pumping equipment to be used. | | | |

RECORDED
INDEXED
MAY 20 1974

MISS. BD OF WATER COMMISSIONERS

If well telescopes please sketch and show depths.

GROUND LEVEL

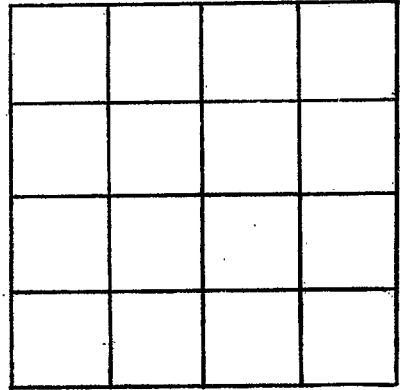

SECTION _____

Please indicate well location X.

ADDITIONAL INFORMATION

If more than one screen, show locations of each on sketch.