

WASH.
D 148
11-14-74

MISSISSIPPI
BOARD OF WATER COMMISSIONERS
416 North State Street
Jackson, Mississippi 39201 **CODED**

WATER WELL DRILLERS LOG

No. 14 1974 Schultz Drilling Washington
date well completed firm name county well located

LANDOWNER:	description of formations encountered	from	to
Lloyd TURNER	Clay	0	21
P.O. Box 5051	Sand	21	98
Rosenville Miss (mailing address)	Sandy shell Clay	98	390
WELL LOCATION:	Sand	390	470
sec 26 T 18 N R 8 E S W			
(distance) miles (direction) of (nearest town)			
WELL PURPOSE: (home, irrigation, municipal, industrial)			
WELL COMPLETION DATA:			
(1) diameter (inches) 2"			
(2) total depth (feet) 460			
(3) static water level (feet) 47 below top of ground.			
(4) casing Five (material) (depth)			
(size) if telescope see back.			
(5) screen 15 (length) (depth to top)			
2" (size) (material)			
(6) pump 1 (HP) 10 (yield gpm)			
Electric (type power)			
(7) electric log NO (yes or no)			
(organization running log)			
(8) how well bottom plugged Bypass			
DRILLERS REMARKS:			


CODED

RECEIVED
DEC 13 1974

MISS. Bd. OF WATER COMMISSIONERS

If well telescopes please sketch and show depths.

GROUND LEVEL

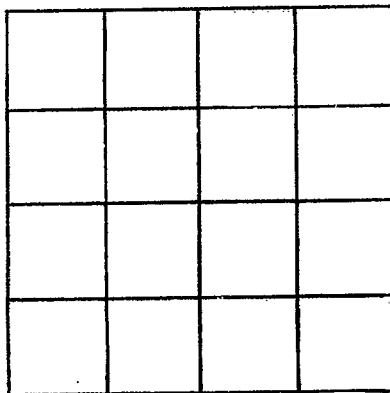

SECTION _____

Please indicate well location X.

ADDITIONAL INFORMATION

If more than one screen,
show locations of each on sketch.