


If well telescopes please sketch and show depths.

GROUND LEVEL

160 ft

349-2 ft

20 ft
Screen

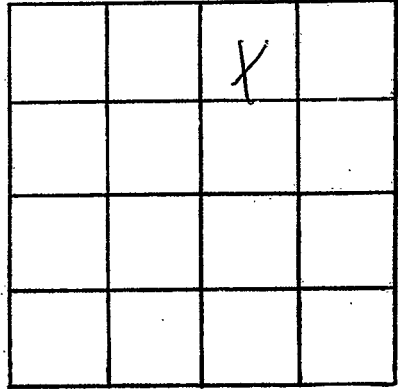

SECTION 33

Please indicate well location X.

ADDITIONAL INFORMATION

If more than one screen,
show locations of each on sketch.