

Washington
 D 150
 6-13-75

MISSISSIPPI
 BOARD OF WATER COMMISSIONERS
 416 North State Street
 Jackson, Mississippi 39201

CODED

WATER WELL DRILLERS LOG

June 13 1975 date well completed
 Schultz firm name
 Wash county well located

LANDOWNER:	description of formations encountered	from	to
Jiggs	Top Soil	0	22
Grenville Miss (mailing address)	Sand	22	80

WELL LOCATION:
 sec. 25 T 18 N R 8 W 15L
 1 miles E of 611
 (distance) (direction) (nearest town)


WELL PURPOSE: Home
 (home, irrigation, municipal, industrial)

- WELL COMPLETION DATA:
- diameter (inches) 2"
 - total depth (feet) 65
 - static water level (feet) 12 below top of ground
 - casing (material) P.V.C. (depth) _____
 (size) If telescope see back.
 - screen (length) 5 (depth to top) _____
 (size) 2" (material) P.V.C.
 - pump (HP) _____ (yield gpm) _____
 (type power) _____
 - electric log NO (yes or no)
 (organization running log) _____
 - how well bottom plugged Cap

DRILLERS REMARKS:
 JUL - 2 1975
 MISSISSIPPI BOARD OF WATER COMMISSIONERS

If well telescopes please sketch and show depths.

GROUND LEVEL

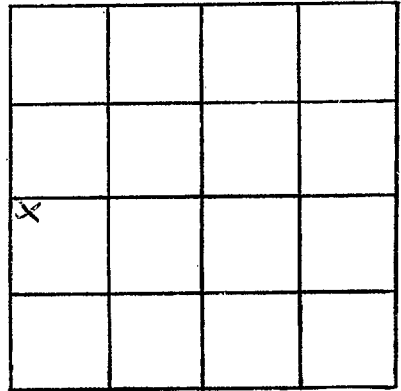

SECTION 25

Please indicate well location X.

ADDITIONAL INFORMATION

If more than one screen,
show locations of each on sketch.