

Washington
 D 151
 6-2-75

MISSISSIPPI
 BOARD OF WATER COMMISSIONERS
 416 North State Street
 Jackson, Mississippi 39201

CODED

WATER WELL DRILLERS LOG

June 2 1975 Schultz Drilling Washington
 (date well completed) (firm name) (county well located)


LANDOWNER: <u>Crownville Canal</u>	description of formations encountered	from	to
<u>Crownville, Miss</u> (mailing address)	<u>Top Soil</u>	<u>0</u>	<u>19</u>
	<u>Sand</u>	<u>19</u>	<u>100</u>
WELL LOCATION: sec. <u>IN CITY</u> T <u>N</u> R <u>E</u> (distance) miles (direction) of (nearest town)			
WELL PURPOSE: <u>INDUSTRIAL</u> (home, irrigation, municipal, industrial)			
WELL COMPLETION DATA:			
(1) diameter (inches) <u>8</u>			
(2) total depth (feet) <u>98</u>			
(3) static water level (feet) <u>10</u> below above top of ground.			
(4) casing <u>Steel</u> <u>78</u> (material) (depth)			
<u>NO</u> if telescope see back. (size)			
(5) screen <u>20</u> <u>Calc</u> (length) (depth to top)			
<u>6"</u> <u>Calc</u> (size) (material)			
(6) pump <u>20</u> <u>250</u> (HP) (yield gpm)			
<u>Elec</u> (type power)			
(7) electric log <u>NO</u> (yes or no)			
(organization running log)			
(8) how well bottom plugged <u>well</u>			
DRILLERS REMARKS:			

DECEMBER 1975
 1975 - 2 1975

MISS. BD. OF WATER COMMISSIONERS

If well telescopes please sketch and show depths.

GROUND LEVEL

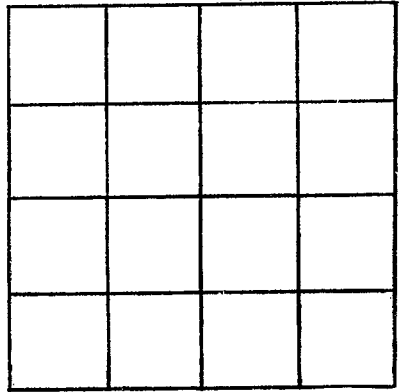

SECTION _____

Please indicate well location X.

ADDITIONAL INFORMATION

If more than one screen,
show locations of each on sketch.