

WASH.  
 D 153  
 6-15-76

MISSISSIPPI  
 BOARD OF WATER COMMISSIONERS  
 416 North State Street  
 Jackson, Mississippi 39201

plu 120'

WATER WELL DRILLERS LOG

CODED

15 June 1976 Lambert Dr, Nipca Wash  
 date well completed firm name county well located

LANDOWNER:  
 City of Greenville  
 (mailing address)

description of formations encountered

WELL LOCATION:  
 sec. 15 T. 18 N. R. 5 E. S. 8 W.  
 4 miles S/W of Greenville  
 (distance) (direction) (nearest town)

from to  
 mixed e 15  
 Sand 15 65

WELL PURPOSE: Municipal  
 (home, irrigation, municipal, industrial)

Sand & Gravel 65 105  
 Clay shell 105 145

WELL COMPLETION DATA:

Clay 145 270

(1) diameter (inches) 6x4

Clay st Sand 270 360

(2) total depth (feet) 525

Sand st Clay 360 455

(3) static water level (feet) 56 below above top of ground.

Sand Fine 455 470

(4) casing Steel 495 (material) (depth)

Sand med. 470 485

6x4 If telescope see back. (size)

Sand coarse 485 540

(5) screen 30' 525 495 (length) (depth to top)

4" S.S. (size) (material)

(6) pump 10 125 (HP) (yield gpm)

Elect (type power)

(7) electric log (yes or no)

(organization running log)

(8) how well bottom plugged back wash

CODED

RECEIVED

AUG 3 - 1976

DRILLERS REMARKS:

MISS. BD. OF WATER COMMISSIONERS

If well telescopes please sketch and show depths.

GROUND LEVEL

6"

160


4"

495

4"

55.  
SCREEN

525

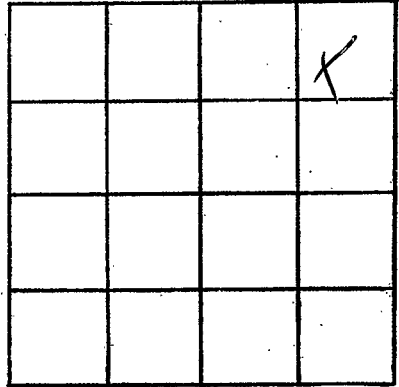

SECTION 25

Please indicate well location X.

ADDITIONAL INFORMATION

If more than one screen, show locations of each on sketch.