

WASH.
 D 158
 11/15/79

MISSISSIPPI
 BOARD OF WATER COMMISSIONERS
 416 North State Street
 Jackson, Mississippi 39201

CODED

WATER WELL DRILLERS LOG

11/15 1979 date well completed
 CORDAGE DRILLING, INC. firm name
 Washington county well located

LANDOWNER: Kobby Higgs
 CORDAGE DR. FOUNDRY & MFG.
 GREENVILLE Ms.
 (mailing address)

description of formations encountered	from	to
clay	0	20
well	20	60
gravel	60	70

WELL LOCATION:
 sec. 32 T-18 N R-8 E
 2 miles S of GREENVILLE
 (distance) (direction) (nearest town)

CODED

WELL PURPOSE: Irrigation
 (home, irrigation, municipal, industrial)

- WELL COMPLETION DATA:
- (1) diameter (inches) 4 in.
 - (2) total depth (feet) 70
 - (3) static water level (feet) 7 below top of ground.
 - (4) casing PVC 60 (material) (depth)
 - 4 (size) if telescope see back.
 - (5) screen 10' 60 (length) (depth to top)
 - 4" D.I.T. PVC (size) (material)
 - (6) pump 1/2 55 (HP) (yield gpm)
 - ELECTRIC (type power)
 - (7) electric log No (yes or no)
 - (organization running log)
 - (8) how well bottom plugged
 1/2" L. DR. WIRE VALVE


DRILLERS REMARKS:

DEPT. OF NATURAL RESOURCES
 BUREAU OF LAND & WATER RESOURCES

RECEIVED
 DEC - 3 1979

If well telescopes please
sketch and show depths.

GROUND LEVEL

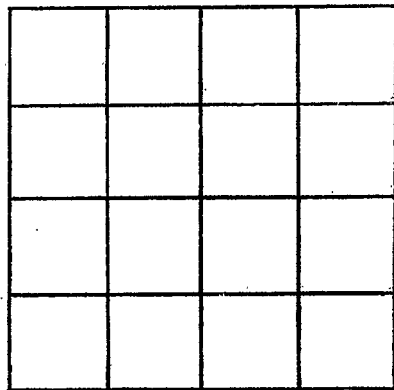

SECTION _____

Please indicate well location X.

ADDITIONAL INFORMATION

If more than one screen,
show locations of each on sketch.