

WASH.

D 159

11/19/79

MISSISSIPPI BOARD OF WATER COMMISSIONERS 416 North State Street Jackson, Mississippi 39201

CODED

WATER WELL DRILLERS LOG

11/19/79 date well completed

1979 CORDAGE Drilling firm name

Washington county well located

LANDOWNER: LEIGH WICKS

Auburn Dr

Gulite MS. (mailing address)

description of formations encountered

from

to

Clay 0 20 SAND 20 60 gravel 60 110

WELL LOCATION:

sec. 31 T18 N R 8 E S 2 miles S of Gulite (distance) (direction) (nearest town)

CODED

WELL PURPOSE: Irrigation (home, irrigation, municipal, industrial)

WELL COMPLETION DATA:

- (1) diameter (inches) 4 1/2
(2) total depth (feet) 70
(3) static water level (feet) 7 below above top of ground.
(4) casing PVC 60 (material) (depth)
4 If telescope see back. (size)
(5) screen 10' 60' (length) (depth to top)
4" 12' PVC (size) (material)
(6) pump 1/2 (HP) 35 (yield gpm)
Electric (type power)
(7) electric log No (yes or no)

(organization running log)

(8) how well bottom plugged back & res. value


DRILLERS REMARKS:

DEPT. OF NATURAL RESOURCES BUREAU OF LAND & WATER RESOURCES

RECEIVED DEC - 3 1979

If well telescopes please  
sketch and show depths.

GROUND LEVEL

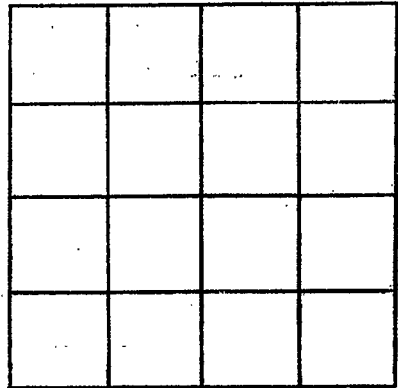

SECTION \_\_\_\_\_

Please indicate well location X.

ADDITIONAL INFORMATION

If more than one screen,  
show locations of each on sketch.