

Washington
D-160
8-30-79

MISSISSIPPI
BOARD OF WATER COMMISSIONERS
416 North State Street
Jackson, Mississippi 39201

WATER WELL DRILLERS LOG

30 days date well completed 1979 Lambert Drillers Wash firm name county well located

LANDOWNER:
Washington School
Greenville Miss.
(mailing address)

WELL LOCATION:
sec. 24 T 18 N R 8 E
S W
1 miles S/E of Greenville
(distance) (direction) (nearest town)

WELL PURPOSE: School
(home, irrigation, municipal, industrial)

- WELL COMPLETION DATA:
- (1) diameter (inches) 4x3
 - (2) total depth (feet) 420
 - (3) static water level (feet) 41 below above top of ground.
 - (4) casing PVC, 406 (material) (depth) 4x3 if telescope see back. (size)
 - (5) screen 20, 420-400 (length) (depth to top) 3" PVC (size) (material)
 - (6) pump 5, 70 (HP) (yield gpm) elect (type power)
 - (7) electric log (yes or no)
- (organization running log)
- (8) how well bottom plugged back press.

description of formations encountered	from	to
Clay	0	30
Sand & gravel	30	95
blue shell	95	130
Clay	130	210
Clay & Sand	210	260
rock	260	261
Clay	261	270
rock	270	271
Sand & clay	271	346
rock	346	347
Clay	347	365
Sand good	365	430

DEPT. OF NATURAL RESOURCES
BUREAU OF LAND & WATER RESOURCES

JAN 9 1980

RECEIVED

DRILLERS REMARKS:


If well telescopes please sketch and show depths.

GROUND LEVEL

4" 180

3" 400

50V 3" 420

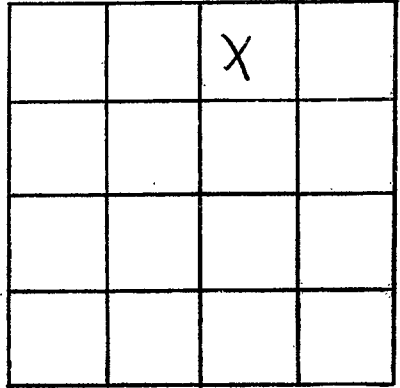

SECTION 24

Please indicate well location X.

ADDITIONAL INFORMATION

If more than one screen, show locations of each on sketch.