

MISSISSIPPI DEPARTMENT OF NATURAL RESOURCES

Bureau of Land and Water Resources

Southport Mall

P.O. Box 10631

Jackson, Mississippi 39209

WATER WELL DRILLERS LOG

**CODED**


WASHINGTON

D 163

6-26-80

26 Jan 81 Lambert Drilling Wash  
 date well completed firm name county well located

LANDOWNER:	description of formations encountered	from	to
Cha Marchbanks Bogoo Rd. Greenville, Miss. (mailing address)			
WELL LOCATION: sec. 32 T 18 N R 9 E 3 miles S of Green (distance) (direction) (nearest town)	Sand & Gravel	10	70
WELL PURPOSE: none (home, irrigation, municipal, industrial)	Sand	70	80
WELL COMPLETION DATA: (1) diameter (inches) 4x3	blue shell	80	210
(2) total depth (feet) 480	Clay & sand	210	340
(3) static water level (feet) 52 below top of ground.	Sand & Clay	340	420
(4) casing PVC 460 (material), (depth)	Sand Gravel	420	440
4x3 (size) if telescope see back.	Sand gravel	440	480
(5) screen 20 480-460 (length), (depth to top)			
3 55 (size), (material)			
(6) pump 50 50 (HP), (yield gpm)			
elect (type power)			
(7) electric log no (yes or no)			
(organization running log)			
(8) how well bottom plugged back press.			
DRILLERS REMARKS:			

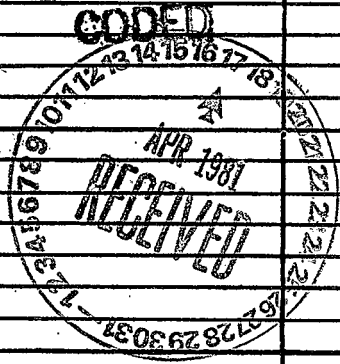


If well telescopes please sketch and show depths.

GROUND LEVEL

~~460~~ 4"

~~460~~ 3"

~~480~~ 3" screen

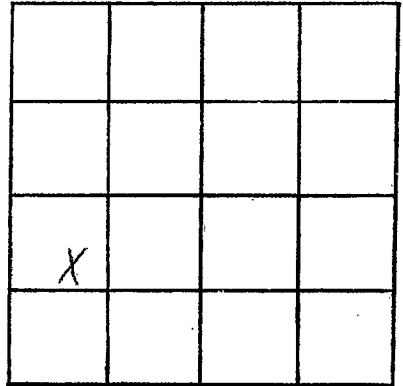

SECTION 32

Please indicate well location X.

ADDITIONAL INFORMATION

If more than one screen,  
show locations of each on sketch.