

MISSISSIPPI DEPARTMENT OF NATURAL RESOURCES

Bureau of Land and Water Resources

Southport Mall

P.O. Box 10631

Jackson, Mississippi 39209

WATER WELL DRILLERS LOG

CODED

Washington
D 164
May 11/81

11 May 1981 date well completed
Hambert Drilling firm name
Wash county well located

LANDOWNER:
John Toler
Oak Dr.
(mailing address)

WELL LOCATION:
sec. 32 T 18 N R 8 E
3 miles S/W of Green
(distance) (direction) (nearest town)

WELL PURPOSE:
home, irrigation, municipal, industrial

WELL COMPLETION DATA:
(1) diameter (inches) 4x2
(2) total depth (feet) 460
(3) static water level (feet) 46 below top of ground.
(4) casing PVC, 380 (material) (depth)
4x2 (size) if telescope see back.
(5) screen 20 (length) 400-380 (depth to top)
2" (size) PVC (material)
(6) pump 1/2 (HP) 27 (yield gpm)
elect (type power)
(7) electric log NO (yes or no)
(organization running log)

(8) how well bottom plugged
backfills

DRILLERS REMARKS:

description of formations encountered	from	to
Mixed	0	20
Sand	0	40
Sand & gravel	40	85
Clay blue	85	160
Clay & sand	160	195
Sand	195	368
Sand & shaly	368	373
Sand	373	405

CODED

DEPT. OF NATURAL RESOURCES
BUREAU OF LAND & WATER RESOURCES

MAY 13 1981

RECEIVED

If well telescopes please sketch and show depths.


GROUND LEVEL

140 4

380 2 1/2

1000 2" screen

If more than one screen, show locations of each on sketch.

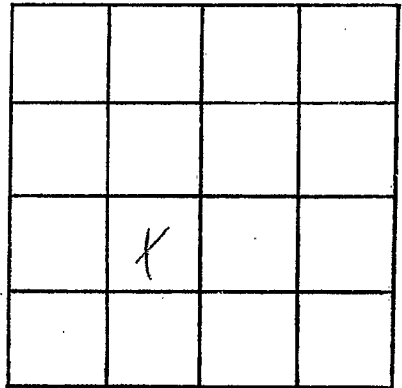

SECTION 32

Please indicate well location X.

ADDITIONAL INFORMATION

Lined area for additional information.