

MISSISSIPPI DEPARTMENT OF NATURAL RESOURCES

Bureau of Land and Water Resources

Southport Mall

P.O. Box 10631

Jackson, Mississippi 39209

WATER WELL DRILLERS LOG **CODED**

Washington  
D 166  
3/26/81

26 mar 1981 Lambert Drilling Wash  
date well completed firm name county well located

LANDOWNER:  
Greenlawn Gardens.  
High 82 E Green  
(mailing address)  
WELL LOCATION:  
sec. 26 T 18 N, R. 8 E  
4 miles E of Green.  
(distance) (direction) (nearest town)

description of formations encountered	from	to
	<u>Clay</u>	<u>0</u>
<u>Sand</u>	<u>30</u>	<u>55</u>
<u>pea gravel</u>	<u>55</u>	<u>87</u>
<u>Clay blue</u>	<u>87</u>	<u>191</u>
<u>Clay st sand</u>	<u>191</u>	<u>260</u>
<u>sand st clay</u>	<u>260</u>	<u>300</u>
<u>Sand</u>	<u>300</u>	<u>374</u>

WELL PURPOSE: irr.  
(home, irrigation, municipal, industrial)

WELL COMPLETION DATA:  
(1) diameter (inches) 4 1/2  
(2) total depth (feet) 371  
(3) static water level (feet) 42 below above top of ground.  
(4) casing PVC, 357  
(material) (depth)  
4 1/2 If telescope see back.  
(size)  
(5) screen 20, 357-371  
(length) (depth to top)  
2 1/2 PVC  
(size) (material)  
(6) pump 1 1/2, 27  
(HP) (yield gpm)  
elect  
(type power)  
(7) electric log no  
(yes or no)  
(organization running log)

(8) how well bottom plugged back press

DRILLERS REMARKS:

**CODED**

DEPT. OF NATURAL RESOURCES  
BUREAU OF LAND & WATER RESOURCES

MAY 18 1981

**RECEIVED**


If well telescopes please sketch and show depths.

GROUND LEVEL

140 4''

351 2''

371 2'' 5cr.

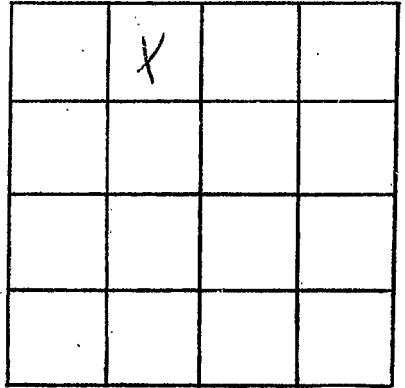

SECTION 26

Please indicate well location X.

ADDITIONAL INFORMATION

If more than one screen, show locations of each on sketch.