

MISSISSIPPI DEPARTMENT OF NATURAL RESOURCES

Bureau of Land and Water Resources

Southport Mall

P.O. Box 10631

Jackson, Mississippi 39209

WATER WELL DRILLERS LOG

CODED

Washington  
D 167  
3/17/81

17 Mar 1981 date well completed  
Lambert Drilling firm name  
Wash county well located

LANDOWNER:	description of formations encountered	from	to
Bob Robinson Bagon Rd. - Green. (mailing address)	mixed	0	15
WELL LOCATION: sec. 38 T 15 N R 8 E 4 miles SW of Green. (distance) (direction) (nearest town)	sand	15	65
WELL PURPOSE: none (home, irrigation, municipal, industrial)	fine gravel	65	92
WELL COMPLETION DATA:	Lime Shell	92	195
(1) diameter (inches) 4 1/2	Clay & sand	192	280
(2) total depth (feet) 405	Sand	280	410
(3) static water level (feet) 46 below top of ground.			
(4) casing PVC 385 (material) (depth) 4 1/2 (size) if telescope see back.			
(5) screen 20 1405-385 (length) (depth to top)			
2 (size) PVC (material)			
(6) pump 1/2 27 (HP) (yield gpm)			
elect (type power)			
(7) electric log NO (yes or no)			
(organization running log)			
(8) how well bottom plugged back pass			
DRILLERS REMARKS:			

CODED

DEPT. OF NATURAL RESOURCES  
BUREAU OF LAND & WATER RESOURCES

MAY 18 1981

RECEIVED


If well telescopes please sketch and show depths.

GROUND LEVEL

140 4''

385 2''

405 2'' screen

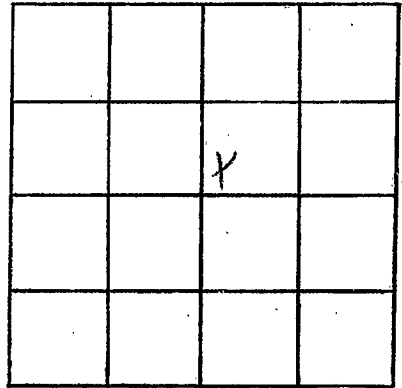

SECTION 39

Please indicate well location X.

ADDITIONAL INFORMATION

If more than one screen,  
show locations of each on sketch.