

MISSISSIPPI DEPARTMENT OF NATURAL RESOURCES

Bureau of Land and Water Resources

Southport Mall

P.O. Box 10631

Jackson, Mississippi 39209

CODED

WATER WELL DRILLERS LOG

Washington
D 168
3/9/81
9 Mar 1981
 date well completed

Lambert Dr. Inc
 firm name

Wash.
 county well located

LANDOWNER:	description of formations encountered	from	to
<u>Shapley Const. Co.</u> <u>Creekmore Rd.</u> (mailing address)	<u>Mixed</u>	<u>0</u>	<u>15</u>
WELL LOCATION: sec. <u>83</u> T. <u>18</u> N. R. <u>8</u> E. <u>3</u> miles <u>S/W</u> of <u>Green</u> (distance) (direction) (nearest town)	<u>Sand</u>	<u>15</u>	<u>60</u>
WELL PURPOSE: <u>home</u> (home, irrigation, municipal, industrial)	<u>Red gravel</u>	<u>60</u>	<u>96</u>
WELL COMPLETION DATA:	<u>Blue shell clay</u>	<u>96</u>	<u>192</u>
(1) diameter (inches) <u>4x2</u>	<u>Clay st sand</u>	<u>192</u>	<u>310</u>
(2) total depth (feet) <u>485</u>	<u>Sand st clay</u>	<u>310</u>	<u>430</u>
(3) static water level (feet) <u>76</u> below above top of ground.	<u>Sand</u>	<u>430</u>	<u>490</u>
(4) casing <u>PVC</u> , <u>465</u> (material) (depth)			
<u>4x2</u> if telescope see back. (size)			
(5) screen <u>20</u> , <u>485-465</u> (length) (depth to top)			
<u>2</u> , <u>PVC</u> (size) (material)			
(6) pump <u>1 1/2</u> , <u>27</u> (HP) (yield gpm)			
<u>elect</u> (type power)			
(7) electric log _____ (yes or no)			
_____ (organization running log)			
(8) how well bottom plugged <u>back pass</u>			
DRILLERS REMARKS:			

CODED

DEPT. OF NATURAL RESOURCES
 BUREAU OF LAND & WATER RESOURCES

MAY 18 1981

RECEIVED


If well telescopes please sketch and show depths.

GROUND LEVEL

140 4"

465 2"

485 2" sc1

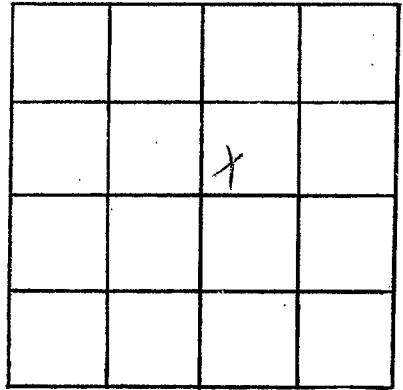

SECTION 33

Please indicate well location X.

ADDITIONAL INFORMATION

If more than one screen, show locations of each on sketch.