

WASHINGTON
 D 170
 4-18-81

MISSISSIPPI DEPARTMENT OF NATURAL RESOURCES
 Bureau of Land and Water Resources
 Southport Mall
 P.O. Box 10631
 Jackson, Mississippi 39209
WATER WELL DRILLERS LOG

CODED

April 18 1981 date well completed
 Larry's Well & Pump firm name
 Washington county well located

LANDOWNER:	description of formations encountered	from	to
AC. Belue			
Greenville, Mo (mailing address)	CLAY FINE SAND Med & COARSE SAND	0 30 45	30 45 90
WELL LOCATION: sec. 27 T. 18 N R. 8 E 2 miles SE of Greenville (distance) (direction) (nearest town)			
WELL PURPOSE: (home, irrigation, municipal, industrial)			
WELL COMPLETION DATA:			
(1) diameter (inches) 16"			
(2) total depth (feet) 90'			
(3) static water level (feet) 20' below top of ground.			
(4) casing Steel, 50' (material) (depth)			
(size) If telescope see back.			
(5) screen 40', 50' (length) (depth to top)			
16", Steel (size) (material)			
(6) pump 60 3000 (HP) (yield gpm)			
(type power)			
(7) electric log NO (yes or no)			
(organization running log)			
(8) how well bottom plugged steel Plate			
DRILLERS REMARKS:			

CODED


DEPT. OF NATURAL RESOURCES
 BUREAU OF LAND & WATER RESOURCES

OCT 19 1981

RECEIVED

If well telescopes please
sketch and show depths.

GROUND LEVEL

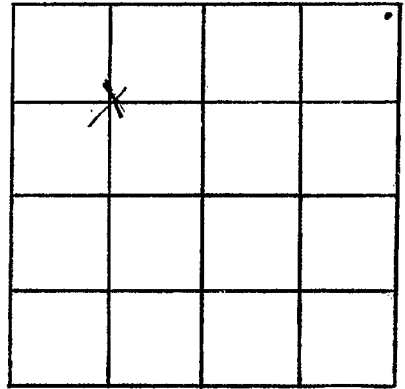

SECTION 27

Please indicate well location X.

ADDITIONAL INFORMATION

If more than one screen,
show locations of each on sketch.