

MISSISSIPPI DEPARTMENT OF NATURAL RESOURCES

Bureau of Land and Water Resources

Southport Mall

P.O. Box 10631

Jackson, Mississippi 39209

WATER WELL DRILLERS LOG

CODED

WASHINGTON

0181

GW6801

11/15/83

11-15

1983

Schultz Drilling

Washington

date well completed

firm name

county well located

LANDOWNER:

C G. Steel

Longwood, Greenville Ms

(mailing address)

description of formations encountered

from

to

Clay

Coarse SAND

Coarse SAND +

pea gravel

Coarse SAND pea

gravel + gravel

0 28

28 35

35 50

50 80

WELL LOCATION:

sec. 27 T. 18 N. R. 8 E
 2 miles E of Greenville
 (distance) (direction) (nearest town)

WELL PURPOSE: IRRIGATION
 (home, irrigation, municipal, industrial)

WELL COMPLETION DATA:

- (1) diameter (inches) 16"
- (2) total depth (feet) 80'
- (3) static water level (feet) 28' below above top of ground.
- (4) casing PVC 40' (material) (depth)

(size) If telescope see back.

- (5) screen 40' 40' (length) (depth to top)
 16" PVC (size) (material)

- (6) pump None EST. 1500 (HP) (yield gpm)

None (type power)

- (7) electric log NO (yes or no)

NO (organization running log)

- (8) how well bottom plugged PVC CAP

CODED

DRILLERS REMARKS:


DEPT. OF NATURAL RESOURCES
 BUREAU OF LAND & WATER RESOURCES

NOV 23 1983

RECEIVED

If well telescopes please sketch and show depths.

GROUND LEVEL

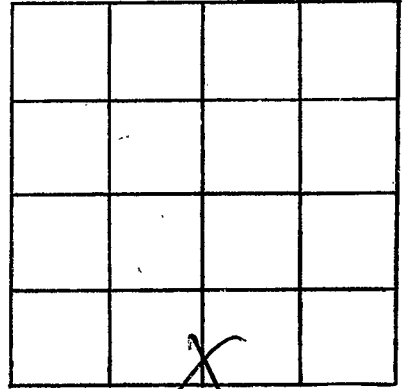

SECTION 27

Please indicate well location X.

ADDITIONAL INFORMATION

If more than one screen, show locations of each on sketch.