

MISSISSIPPI DEPARTMENT OF NATURAL RESOURCES

Bureau of Land and Water Resources

Southport Mall

P.O. Box 10631

Jackson, Mississippi 39209

WATER WELL DRILLERS LOG

CODED

WASHINGTON
D 182
11/17/83

11-17 1983 Schultz Drilling Washington
 date well completed firm name county well located

LANDOWNER:	description of formations encountered	from	to
C G Steele			
LONGWOOD FARMS Greenville (mailing address)	Clay SAND	0 21	21 40
WELL LOCATION:	SAND + PEA GRAVEL	40	65
sec. 30 T. 18 N. R. 8 E. S. 5	PEA GRAVEL + GRAVEL	65	83
4 miles E of Greenville (distance) (direction) (nearest town)	CLAY	83	
WELL PURPOSE: IRRIGATION (home, irrigation, municipal, industrial)			
WELL COMPLETION DATA:			
(1) diameter (inches) 16"			
(2) total depth (feet) 83'			
(3) static water level (feet) 24' below top of ground.			
(4) casing PVC 43' (material) (depth)			
(size) if telescope see back.			
(5) screen 40' 43' (length) (depth to top)			
16" PVC (size) (material)			
(6) pump NONE EST. 1500 (HP) (yield gpm)			
NONE (type power)			
(7) electric log NO (yes or no)			
NONE (organization running log)			
(8) how well bottom plugged PVC CAP.			
DRILLERS REMARKS:			

CODED


DEPT. OF NATURAL RESOURCES
 BUREAU OF LAND & WATER RESOURCES

NOV 23 1983

RECEIVED

If well telescopes please sketch and show depths.

GROUND LEVEL

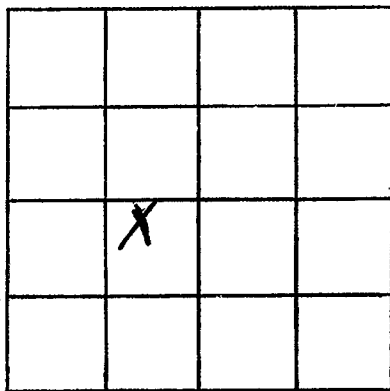

SECTION 30

Please indicate well location X.

ADDITIONAL INFORMATION

If more than one screen,
show locations of each on sketch.