

WASHINGTON
 CI-2974 D183

MISSISSIPPI DEPARTMENT OF NATURAL RESOURCES
 Bureau of Land and Water Resources
 Southport Mall
 P.O. Box 10631
 Jackson, Mississippi 39209
 WATER WELL DRILLERS LOG

CODED

April 19 85 LAVNE-CENTRAL CO. WASHINGTON
 date well completed firm name county well located

LANDOWNER:
 CHEVRON CHEMICAL
 LELAND, MS
 (mailing address)

description of fomations encountered	from	to
clay	0	25
fine sand	25	64
coarse sand/pea gravel	64	84
clay	84	94

WELL LOCATION: #20
 sec. 7 T 18N R 8 E
 W
 3 miles E of Greenville
 (distance) (direction) (nearest town)

CODED

WELL PURPOSE: industrial
 (home, irrigation, municipal, industrial)

WELL COMPLETION DATA:

- (1) diameter (inches) 20"
- (2) total depth (feet) 86'
- (3) static water level (feet) 12' below top of ground.
- (4) casing PVC 66',
 (material) (depth)
 8" If telescope see back.
 (size)
- (5) screen 20' 66'
 (length) (depth to top)
 8" PVC
 (size) (material)
- (6) pump 40 350
 (HP) (yield gpm)
 elec.
 (type power)
- (7) electric log no
 (yes or no)
 (organization running log)
- (8) how well bottom plugged PVC plug


DRILLERS REMARKS:

RECEIVED
 JUL 9 - 1985

Department of Natural Resources
 Bureau of Land & Water Resources

If well telescopes please sketch and show depths.

GROUND LEVEL

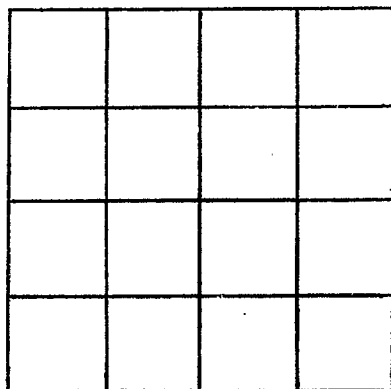

SECTION _____

Please indicate well location X.

ADDITIONAL INFORMATION

If more than one screen,
show locations of each on sketch.