

WASHINGTON

CI-3007-D184

MISSISSIPPI DEPARTMENT OF NATURAL RESOURCES  
Bureau of Land and Water Resources  
Southport Mall  
P.O. Box 10631  
Jackson, Mississippi 39209  
WATER WELL DRILLERS LOG

CODED

6/6 1985 LAYNE-CENTRAL COMPANY WASHINGTON  
date well completed firm name county well located

LANDOWNER:	description of formations encountered	from	to
CHEVRON CHEMICAL CO.			
STONEVILLE, MS	sand	18	77
(mailing address)	gravel	77	88
WELL LOCATION: #1	blue clay	88	228
sec. 7 T 18 N R 8 E	sandy shale	228	392
3 miles E of Greenville	clay	392	394
(distance) (direction) (nearest town)	sandy clay	394	420
	sand	420	430
	clay	430	438
	sand	438	486

CODED

WELL PURPOSE: industrial  
(home, irrigation, municipal, industrial)

WELL COMPLETION DATA:

(1) diameter (inches) 6"

(2) total depth (feet) 289' 3"

(3) static water level (feet) 12 below top of ground.

(4) casing PVC 161' 6" (material), (depth), 4" (size) if telescope see back.

(5) screen 30 450 (length), (depth to top) 2" PVC (size), (material)

(6) pump 2 40 (HP), (yield gpm) elec. (type power)

(7) electric log no (yes or no) (organization running log)

(8) how well bottom plugged PVC plug

RECEIVED


JUL 8 1985

DRILLERS REMARKS:

Department of Natural Resources  
Bureau of Land & Water Resources

If well telescopes please sketch and show depths.

GROUND LEVEL

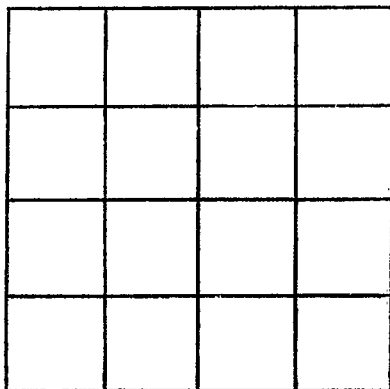

SECTION \_\_\_\_\_

Please indicate well location X.

ADDITIONAL INFORMATION

If more than one screen,  
show locations of each on sketch.