

Washington
 D185
 7-8-85

MISSISSIPPI DEPARTMENT OF NATURAL RESOURCES
 Bureau of Land and Water Resources
 Southport Mall
 P.O. Box 10631
 Jackson, Mississippi 39209
WATER WELL DRILLERS LOG

CODED

7-8-85 19 IRRIGATION EQUIPMENT INC. WASHINGTON
 date well completed firm name county well located

LANDOWNER: Greenville Public
 schools 412 South main st.
 Greenville, ms 38701
 (mailing address)

description of formations encountered	from	to
clay	0	35
Fine sand	35	55
COURSE SAND / PEA GRAVEL	55	95

WELL LOCATION:
 sec. 16 T. 18 N. R. 8 E.
 S W
 4 miles EAST of Greenville
 (distance) (direction) (nearest town)

CODED

WELL PURPOSE: IRRIGATION
 (home, irrigation, municipal, industrial)

- WELL COMPLETION DATA:
- (1) diameter (inches) 16"
 - (2) total depth (feet) 95'
 - (3) static water level (feet) 20' below top of ground.
 - (4) casing PVC, 55'
 (material) (depth)
 (size) if telescope see back.
 - (5) screen 40', 55'
 (length) (depth to top)
 16" PVC
 (size) (material)
 - (6) pump 40 2000
 (HP) (yield gpm)
 Electric
 (type power)
 - (7) electric log NO
 (yes or no)
 (organization running log)
 - (8) how well bottom plugged PVC Bottom CAP

RECEIVED


JUL 24 1985

Department of Natural Resources
 Bureau of Land & Water Resources

DRILLERS REMARKS:

If well telescopes please
sketch and show depths.

GROUND LEVEL

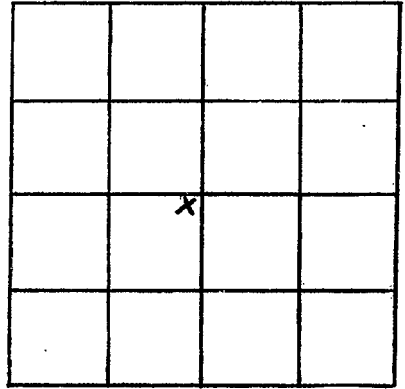

SECTION 16

Please indicate well location X.

ADDITIONAL INFORMATION

If more than one screen,
show locations of each on sketch.