

MISSISSIPPI DEPARTMENT OF NATURAL RESOURCES

Bureau of Land and Water Resources

Southport Mall

P.O. Box 10631

Jackson, Mississippi 39209

WATER WELL DRILLERS LOG

Washington
D 189
145 B

Code

25 June 1987 Lambert Drilling Wash
date well completed firm name county well located

LANDOWNER:
Washington School
Greenville, Miss.
(mailing address)

WELL LOCATION:
sec. 30 T. 18 N. R. 8 E
2 miles S/W of Greenville
(distance) (direction) (nearest town)

WELL PURPOSE: school
(home, irrigation, municipal, industrial)

WELL COMPLETION DATA:

- (1) diameter (inches) 4x2
- (2) total depth (feet) 540
- (3) static water level (feet) 46 below above top of ground.
- (4) casing PVC 500 (material) (depth)
4x2 (size) if telescope see back.
- (5) screen 40" 540-500 (length) (depth to top)
2" PVC (size) (material)
- (6) pump 3 50 (HP) (yield gpm)
elect (type power)
- (7) electric log no (yes or no)
(organization running log)
- (8) how well bottom plugged back grass

description of formations encountered	from	to
Clay	0	20
Sand	20	70
pea gravel	70	98
Clay	98	220
Clay & Sand	220	370
Clay	370	405
rock	405	406
Clay	406	430
Sand Pine	430	450
Sand	450	540

RECEIVED

NOV 25 1987

Department of Natural Resources
Bureau of Land & Water Resources

DRILLERS REMARKS:


If well telescopes please sketch and show depths.

GROUND LEVEL

160 4"

500 2'6"

540 2" Sci.

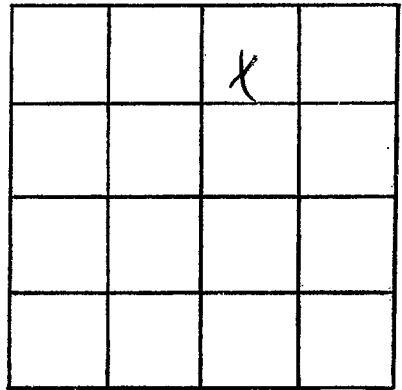

SECTION 80

Please indicate well location X.

ADDITIONAL INFORMATION

If more than one screen, show locations of each on sketch.