

**MISSISSIPPI DEPARTMENT OF ENVIRONMENTAL QUALITY**  
Bureau of Land and Water Resources

P. O. Box 10631  
Jackson, MS 39289-0631  
**WATER WELL DRILLERS LOG**

COUNTY WELL LOCATED <u>Washington</u>	
WELL NUMBER <u>D 192</u>	CODED <input checked="" type="checkbox"/>
DATE WELL COMPLETED <u>6-2-91</u>	

PERMIT NUMBER
NAME OF DRILLING FIRM <u>Schultz Drilling</u>

NAME & MAILING ADDRESS OF LANDOWNER <u>Greenville Gospel Assembly</u> <u>Woodmen of the World Rd</u> <u>Greenville Ms. 38701</u>		
WELL LOCATION: SEC	TOWNSHIP	RANGE
<u>27</u>	<u>18</u>	<u>N 8 E</u>
DISTANCE	DIRECTION	NEAREST TOWN
<u>1</u> Miles	<u>East</u>	of <u>Greenville</u>
OTHER LANDMARK		
WELL PURPOSE <input checked="" type="checkbox"/> Home Irrigation, Municipal, Industrial, Fish Pond, etc.		

<b>PUMP DATA</b>		
PUMP TYPE (Circle One): Submersible, Turbine, <input checked="" type="checkbox"/> Jet, Flowing Well, Other (Describe) _____		
POWER TYPE (Circle One): <input checked="" type="checkbox"/> Electric, Tractor, Diesel, Gasoline, Butane, Other (Describe) _____ H/P <u>1</u>		
Pump Capacity (GPM) <u>10</u>	No. of Stages <u>2</u>	Setting Depth <u>60</u> FT.
PUMP TEST		
Well yielded _____ GPM with a drawdown of _____ ft. after _____ hours of pumping		

<b>WELL DATA</b>		
Well Depth <u>440</u>	Casing Diameter (In.) <u>2</u>	Casing Length (Ft.) <u>420</u>
Type of Casing <u>pvc</u>	Hole Depth <u>440</u>	Depth to Static Water Level <u>31 ft</u>
TYPE OF COMPLETION: (Circle One or More): <input checked="" type="checkbox"/> Gravel Packed, <input type="checkbox"/> Underreamed, <input type="checkbox"/> Telescoped, <input checked="" type="checkbox"/> Natural Development, <input type="checkbox"/> Open Hole, <input type="checkbox"/> Other (Describe) <u>Hole plug</u>		
Top of Lap Pipe or Reduction in Casing		
FEET	IF TELESCOPED OR MORE THAN ONE SCREEN: USE BACK PAGE	

<b>LOG DATA</b>	
TYPE OF LOG RUN (Circle One): <input checked="" type="checkbox"/> No Log Run Electric, Gamma Ray, Density, Sonic, Neutron, Other (Describe) _____	
Name of Organization Running Log	

<b>SCREEN DATA</b>		
Diameter - Inches <u>2</u>	Length - Feet <u>20</u>	Slot Size - Inches <u>.010</u>
Screen Type <u>pvc</u>	Depth to Bottom - Feet <u>440</u>	


<b>GEOLOGIC DATA (Office Use Only)</b>			
Surface Elev.	Geologic Unit	Unit Thickness	Depth to Top
Subs. SWL	Date	Analysis	Aquifer Test
Driller's Remarks			

DESCRIPTION OF FORMATIONS ENCOUNTERED	FROM	TO
<u>clay</u>	<u>0</u>	<u>25</u>
<u>sand</u>	<u>25</u>	<u>40</u>
<u>sand + p-gravel</u>	<u>40</u>	<u>93</u>
<u>clay</u>	<u>93</u>	<u>340</u>
<u>clay + sand streaks</u>	<u>340</u>	<u>400</u>
<u>med to good sand</u>	<u>400</u>	<u>440</u>

FORMATIONS (Continued)	FROM	TO
<b>NO DISSEMINATION</b>		
<b>DEC 06 1991</b>		
<b>Dept. of Environmental Quality</b> <b>Bureau of Land &amp; Water Resources</b>		
IF MORE SPACE IS NEEDED, USE BACK		

If well telescopes please sketch and show depths.

GROUND LEVEL

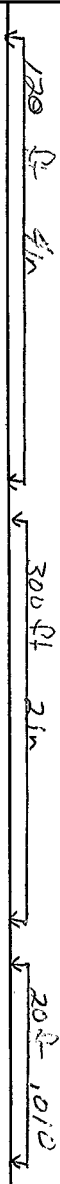

X			

SECTION 27

Please indicate well location X.

ADDITIONAL INFORMATION

---

---

If more than one screen, show location of each on sketch.