

MISSISSIPPI DEPARTMENT OF ENVIRONMENTAL QUALITY

Office of Land and Water Resources

P. O. Box 10631
Jackson, MS 39289-0631
WATER WELL DRILLERS LOG

COUNTY WELL LOCATED
Washington

WELL NUMBER D-214 CODED

DATE WELL COMPLETED
4-20-01

PERMIT NUMBER
MS-6W-38843

NAME OF DRILLING FIRM
Schudco Ltd

NAME & MAILING ADDRESS OF LANDOWNER
GT+T FARMS
Greenville MS 38701

WELL LOCATION: SEC 36 TOWNSHIP 18 RANGE 8
N S E W

DISTANCE 1 Miles DIRECTION SE of NEAREST TOWN Greenville

OTHER LANDMARK

WELL PURPOSE: Home, Irrigation Municipal, Industrial, Fish Pond, etc.

PUMP DATA

PUMP TYPE (Circle One):
Submersible, Turbine, Jet, Flowing Well,
Other (Describe) _____

POWER TYPE (Circle One):
Electric, Tractor, Diesel, Gasoline, Butane,
Other (Describe) _____ H/P 40

Pump Capacity (GPM) 2000 No. of Stages 2 Setting Depth 60 FT.

PUMP TEST

Well yielded _____ GPM with
a drawdown of _____ ft.
after _____ hours of pumping

WELL DATA

Well Depth 93 Casing Diameter (In.) 16 Casing Length (Ft.) 63

Type of Casing pvc Hole Depth 93 Depth to Static Water Level _____

LOG DATA

TYPE OF LOG RUN (Circle One): No Log Run,
Electric, Gamma Ray, Density, Sonic, Neutron,
Other (Describe) _____

Name of Organization Running Log _____

TYPE OF COMPLETION: (Circle One or More):
Gravel Packed, Underreamed, Telescoped,
Natural Development, Open Hole, Other
(Describe) _____

WELL GROUTED TO A DEPTH OF _____ FEET
Type Grout (circle one): Cement, Bentonite, or Mix

GEOLOGIC DATA (Office Use Only)

Surface Elev.	Geologic Unit	Unit Thickness	Depth to Top
Subs. SWL	Date	Analysis	Aquifer Test

SCREEN DATA

Diameter - Inches 16 Length - Feet 30 Slot Size - Inches 1035

Screen Type pvc Depth to Bottom - Feet 93

Driller's Remarks

Top of Lap Pipe or Reduction in Casing

FEET IF TELESCOPED OR MORE THAN ONE SCREEN USE BACK PAGE

DESCRIPTION OF FORMATIONS ENCOUNTERED	FROM	TO
<u>clay - Gumbo</u>	<u>0</u>	<u>47</u>
<u>fine to med sand</u>	<u>47</u>	<u>60</u>
<u>course sand little</u>	<u>60</u>	<u>93</u>
<u>pg + gravel</u>		

RECEIVED


JUL 06 2001

YMD JOINT WATER MANAGEMENT DISTRICT

IF MORE SPACE IS NEEDED, USE BACK

If well telescopes please
sketch and show depths.

GROUND LEVEL

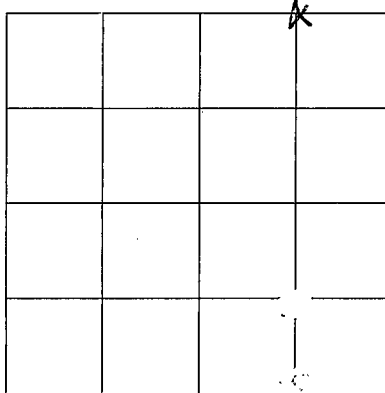

SECTION 36

Please indicate well location X.

ADDITIONAL INFORMATION

If more than one screen,
show location of each on sketch.