

MISSISSIPPI DEPARTMENT OF ENVIRONMENTAL QUALITY

Office of Land and Water Resources

P. O. Box 10631  
Jackson, MS 39289-0631  
WATER WELL DRILLERS LOG

COUNTY WELL LOCATED <u>Washington</u>	
WELL NUMBER <u>D-218</u>	CODED
DATE WELL COMPLETED <u>Jan 12 2004</u>	

PERMIT NUMBER
NAME OF DRILLING FIRM <u>K &amp; S Drilling</u>

NAME & MAILING ADDRESS OF LANDOWNER  
Texas Gas

Latitude:  
Longitude:

WELL LOCATION	SEC <u>3</u>	TOWNSHIP <u>T18</u>	RANGE <u>S R 8 E</u>
---------------	--------------	---------------------	----------------------

DISTANCE	DIRECTION	NEAREST TOWN
<u>3</u> Miles	<u>NE</u>	of <u>Greenville</u>

OTHER LANDMARK  
Greenville

WELL PURPOSE: Home, Irrigation, Municipal, Industrial, Fish Pond, etc.  
Cathodic Protection

WELL DATA

Well Depth <u>180</u>	Casing Diameter (In.)	Casing Length (Ft.)
Type of Casing	Hole Depth	Depth to Static Water Level

TYPE OF COMPLETION: (Circle One or More):  
Gravel Packed, Underreamed, Telescoped, Natural Development, Open Hole, Other (Describe)

WELL GROUTED TO A DEPTH OF 50 FEET  
Type Grout (circle one): Cement, Bentonite, or Mix

SCREEN DATA

Diameter - Inches	Length - Feet	Slot Size - Inches
Screen Type	Depth to Bottom - Feet	

PUMP DATA

PUMP TYPE (Circle One):  
Submersible, Turbine, Jet, Flowing Well,  
Other (Describe)

POWER TYPE (Circle One):  
Electric, Tractor, Diesel, Gasoline, Butane,  
Other (Describe) \_\_\_\_\_ H/P \_\_\_\_\_

DESCRIPTION OF FORMATIONS ENCOUNTERED	FROM	TO
<u>Topsoil</u>	<u>0</u>	<u>5</u>
<u>Sand + clay mix</u>	<u>5</u>	<u>75</u>
<u>sand</u>	<u>75</u>	<u>105</u>
<u>clay</u>	<u>105</u>	<u>180</u>

RECEIVED  
FEB 03 2004  
BY: OLWR

Top of Lap Pipe or Reduction in Casing

FEET IF TELESCOPED OR MORE THAN ONE SCREEN: USE BACK PAGE

I certify that the well was drilled, constructed and completed in accordance with all applicable Requirements of the Mississippi Department of Environmental Quality and/or the Mississippi Department of Health regulations and state laws.


Ma-Hay 0-629  
Signature of Licensed Driller and License No.

Feb 5 2004  
Date

Additional Information Required On Back

If well telescopes please sketch and show depths.

GROUND LEVEL

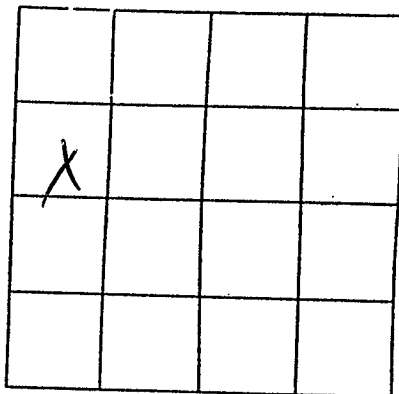

SECTION \_\_\_\_\_

Please indicate well location X.

Pump Capacity (GPM)	No. of Stages	Setting Depth	FT.
PUMP TEST			
Well yielded _____ GPM with			
a drawdown of _____ ft.			
after _____ hours of pumping			

LOG DATA

TYPE OF LOG RUN (Circle One): Electric, Gamma Ray, Density, Sonic, Neutron, Other (Describe) _____	No Log Run
Name of Organization Running Log	

GEOLOGIC DATA (Office Use Only)

Surface Elev.	Geologic Unit	Unit Thickness	Depth to Top
Subs. SWL	Date	Analysis	Aquifer Test

Driller's Remarks

---



---



If more than one screen, show location of each on sketch.