

Washington
 D 1001
 9-29-75

MISSISSIPPI
 BOARD OF WATER COMMISSIONERS
 416 North State Street
 Jackson, Mississippi 39201

WATER WELL DRILLERS LOG

29 sept 1975 date well completed
 Lambert Drilling West firm name
 Wash county well located

LANDOWNER:
 John Nicholas
 (mailing address)

WELL LOCATION:
 sec 2 T 18 N R 8 E
 3 miles N of Green
 (distance) (direction) (nearest town)

WELL PURPOSE: home
 (home, irrigation, municipal, industrial)

- WELL COMPLETION DATA:
- (1) diameter (inches) 2 X 4
 - (2) total depth (feet) 470
 - (3) static water level (feet) 58 above top of ground
 - (4) casing PVC 450 (material) (depth)
 4 X 2 (size) if telescope see back.
 - (5) screen 30' 470-490 (length) (depth to top)
 2" PVC (size) (material)
 - (6) pump 2 30 (HP) (yield gpm)
 Elect (type power)
 - (7) electric log (yes or no)
 - (organization running log)
 - (8) how well bottom plugged back wash

description of formations encountered	depth	
	from	to
mixed	0	20
sand	20	60
sand & gravel	60	94
clay	94	170
clay & sand	170	240
rock	240	242
clay & sand st.	242	285
sand, st. clay	285	370
sand conc.	370	420
sand, good	420	480
Set 470.		

DRILLERS REMARKS:

RECEIVED
 MISSISSIPPI
 OCT 28 1975
 MISS. Bd. OF WATER COMMISSIONERS

If well telescopes please sketch and show depths.

GROUND LEVEL

4"


140

2"

450

2" screen

470

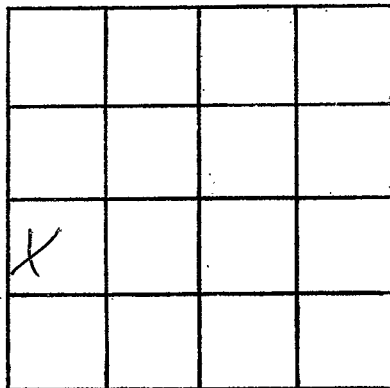

SECTION 2

Please indicate well location X.

ADDITIONAL INFORMATION

If more than one screen, show locations of each on sketch.