

WASH.
D 1002
6-76

MISSISSIPPI
BOARD OF WATER COMMISSIONERS
416 North State Street
Jackson, Mississippi 39201

slw-120'

WATER WELL DRILLERS LOG

Mar - June 1976 Lambert Drilling Wash
date well completed firm name county well located

LANDOWNER:	description of formations encountered	from	to
City of Greenville 110 de-watering wells. (mailing address)			
WELL LOCATION: sec. 15 T 18 N R 8 E S S W 4 miles S/W of Greenville (distance) (direction) (nearest town)	Sand fine.	10	30
WELL PURPOSE: <u>drain</u> (home, irrigation, municipal, industrial)	Sand coarse.	30	45
WELL COMPLETION DATA: (1) diameter (inches) 4" (2) total depth (feet) 45 (3) static water level (feet) 12 below above top of ground. (4) casing PVC 25 (material) (depth) (size) if telescope see back. (5) screen 20 45-25 (length) (depth to top) 4" PVC (size) (material) (6) pump 5 50 (HP) (yield gpm) Elect. (type power) (7) electric log (yes or no) (organization running log) (8) how well bottom plugged Ced.			


RECEIVED
AUG 3 - 1976

DRILLERS REMARKS:
11 de-watering well
for waste water treatment
plant

MISS. BD. OF WATER COMMISSIONERS

If well telescopes please sketch and show depths.

GROUND LEVEL

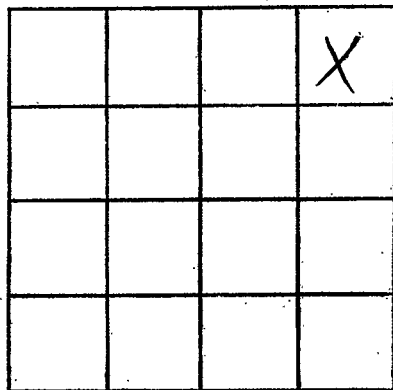

SECTION 15

Please indicate well location X.

ADDITIONAL INFORMATION

If more than one screen,
show locations of each on sketch.