

Washington  
 D 1003  
 7/26/76

MISSISSIPPI  
 BOARD OF WATER COMMISSIONERS  
 416 North State Street  
 151 Jackson, Mississippi 39201

WATER WELL DRILLERS LOG

26 July 1976 Lambert Drilling Co West  
 date well completed firm name county well located


LANDOWNER:	description of formations encountered	from	to
Allen Prestbrage Woodman & World Rd. Greenville (mailing address) MISS	Mixed.	0	30
WELL LOCATION: sec. 27 T 18 N R 8 E S W 3 miles S-E of Greenville (distance) (direction) (nearest town)	Sand.	30	70
WELL PURPOSE: none (home, irrigation, municipal, industrial)	fine gravel	70	92
WELL COMPLETION DATA: (1) diameter (inches) 2 (2) total depth (feet) 460 (3) static water level (feet) 46 below top of ground. (4) casing PVC 450 (material) (depth) If telescope see back. (5) screen 10 460-450 (length) (depth to top) 2" PVC (size) (material) (6) pump 1 10 (HP) (yield gpm) Elect (type power) (7) electric log (yes or no) (organization running log) (8) how well bottom plugged back wash	Blue shell	92	120
	Clay	120	283
	Clay st. sand.	283	320
	Sand. tight	320	410
	Sand. good.	410	465
DRILLERS REMARKS:			

RECEIVED  
 SEP 17 1976

MISS. Bd. OF WATER COMM.

If well telescopes please sketch and show depths.

GROUND LEVEL

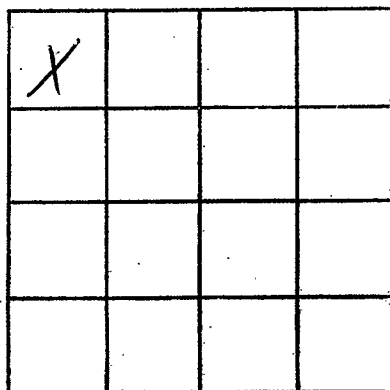

SECTION 27

Please indicate well location X.

ADDITIONAL INFORMATION

If more than one screen,  
show locations of each on sketch.