

WASHINGTON
 D 1004
 10-15-76

MISSISSIPPI
 BOARD OF WATER COMMISSIONERS
 416 North State Street
 Jackson, Mississippi 39201

WATER WELL DRILLERS LOG

15 Oct 1976 date well completed
 Lambert Drilling Co. firm name
 Wash. county well located

LANDOWNER: <u>Ch. Hutchings Sec 1</u> <u>Bill Willis</u>	description of formations encountered	from	to
Lake Fergusar-Greenville (mailing address)	mixed	0	15
WELL LOCATION: sec <u>1</u> T <u>18</u> N R <u>3</u> E <u>3</u> miles <u>N</u> of <u>Orean</u> (distance) (direction) (nearest town)	sand	15	90
WELL PURPOSE: <u>home</u> (home, irrigation, municipal, industrial)	gravel	90	115
WELL COMPLETION DATA: (1) diameter (inches) <u>4 X 2</u>	clay	115	195
(2) total depth (feet) <u>492</u>	Clay st sand	195	240
(3) static water level (feet) <u>125</u> below top of ground.	Sand st clay	240	395
(4) casing <u>PVC</u> , <u>4 1/2</u> (material) (depth)	sand tight	395	425
<u>4 1/2</u> if telescope see back. (size)	sand med	425	460
(5) screen <u>20</u> , <u>492</u> (length) (depth to top)	sand gravel	460	500
<u>2</u> <u>PVC</u> (size) (material)			
(6) pump <u>1</u> , <u>20</u> (HP) (yield gpm)			
<u>elect</u> (type power)			
(7) electric log <u>no</u> (yes or no)			
(organization running log)			
(8) how well bottom plugged <u>back wash</u>			
DRILLERS REMARKS:			

RECEIVED
 JAN 10 1977


WATER COMMISSION

If well telescopes please sketch and show depths.

GROUND LEVEL

140

411

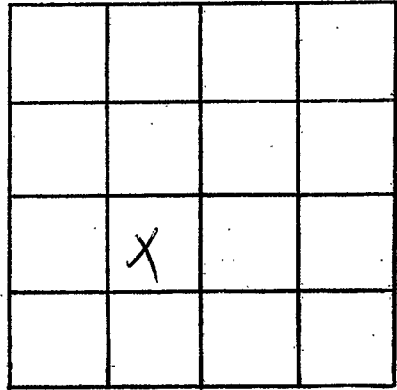

SECTION 1

Please indicate well location X.

ADDITIONAL INFORMATION

211

472

2

211 Screen

492

If more than one screen,
show locations of each on sketch.