

WASHINGTON  
 D 1005  
 1-28-77

MISSISSIPPI  
 BOARD OF WATER COMMISSIONERS  
 416 North State Street  
 152 Jackson, Mississippi 39201

WATER WELL DRILLERS LOG

28 Jan 1977 date well completed  
 Lambert Drilling & Equip. firm name  
 Wash county well located

LANDOWNER:	description of formations encountered	from	to
Dr. Thom. Salmon Greenville, MISS. (mailing address)			
	Sand	15	60
WELL LOCATION: sec. 33 T. 18 N. R. 8 E. S. 4 W. 3 miles S of Greenville (distance) (direction) (nearest town)	Sand & gravel	60	126
	Clay bluo.	126	190
WELL PURPOSE: none (home, irrigation, municipal, industrial)	Clay & sand	190	240
WELL COMPLETION DATA:	Sand, fine.	240	290
(1) diameter (inches) 4x2	Sand.	290	444
(2) total depth (feet) 420			
(3) static water level (feet) 46 below top of ground.			
(4) casing PVC 390 (material) (depth) 4x2 (size) if telescope see back.			
(5) screen 30 420-390 (length) (depth to top) 2 PVC (size) (material)			
(6) pump 2 35 (HP) (yield gpm) ELECT (type power)			
(7) electric log (yes or no)			
(organization running log)			
(8) how well bottom plugged back Wash			
DRILLERS REMARKS:			

RECEIVED  
 MAR - 7 1977

MISS. BD OF WATER COMMISSIONERS

If well telescopes please sketch and show depths.

GROUND LEVEL

140

4"




390

2"

2' screen

420

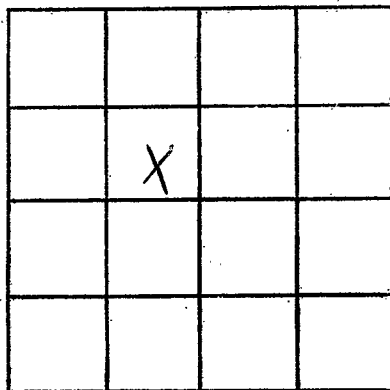

SECTION 33

Please indicate well location X.

ADDITIONAL INFORMATION

If more than one screen, show locations of each on sketch.