

WASHINGTON
D 1006
5-9-77

MISSISSIPPI
BOARD OF WATER COMMISSIONERS
416 North State Street
151 Jackson, Mississippi 39201

WATER WELL DRILLERS LOG

9 May 1977 date well completed
Lambert Drilling Co. firm name
Leakey county well located

LANDOWNER:	description of formations encountered	from	to
Ed. Moore	Mixed	0	25
Greenville, Miss (mailing address)	Sand.	25	60
WELL LOCATION: sec 33 T 18 N R 9 E 8 1/4 miles S of Greenville (distance) (direction) (nearest town)	Sand + gravel	60	102
WELL PURPOSE: none (home, irrigation, municipal, industrial)	Clay blue	102	160
WELL COMPLETION DATA:	Clay	160	240
(1) diameter (inches) 4x2	Clay st Sand	240	410
(2) total depth (feet) 500	Sand, light	410	435
(3) static water level (feet) 41 below top of ground.	Sand, gravel	435	500
(4) casing PVC 480 (material) (depth)			
4x2 (size) if telescope see back.			
(5) screen 20 500-480 (length) (depth to top)			
2" PVC (size) (material)			
(6) pump 1 20 (HP) (yield gpm)			
elect (type power)			
(7) electric log (yes or no)			
(organization running log)			
(8) how well bottom plugged backwash			
DRILLERS REMARKS:			

RECEIVED
JUN 29 1977
MISS. BD. OF WATER COM.


If well telescopes please sketch and show depths.

GROUND LEVEL

140 411

480 2"

500 2" gravel

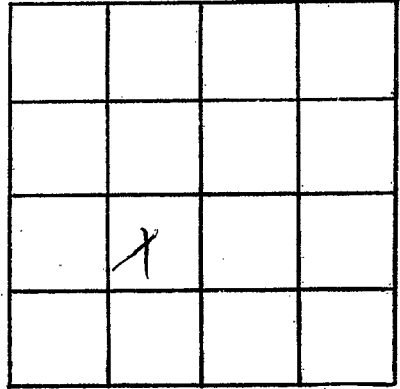

SECTION 35

Please indicate well location X.

ADDITIONAL INFORMATION

If more than one screen, show locations of each on sketch.