

WASHINGTON
D 1008
6-13-77

MISSISSIPPI
BOARD OF WATER COMMISSIONERS
416 North State Street
15F Jackson, Mississippi 39201

WATER WELL DRILLERS LOG

13 June 1977 Lambert Drilling Co. Wash
date well completed firm name county well located



LANDOWNER:	description of formations encountered	from	to
John Barton Greenville, Miss. (mailing address)			
WELL LOCATION: sec. 33 T. 18 N. R. 8 E 8 1/2 miles S of Greenville (distance) (direction) (nearest town)	Clay	0	20
WELL PURPOSE: <u>non</u> (home, irrigation, municipal, industrial)	Sand P.	20	60
WELL COMPLETION DATA: (1) diameter (inches) <u>4 1/2</u> (2) total depth (feet) <u>480</u> (3) static water level (feet) <u>52</u> below/above top of ground. (4) casing <u>PVC</u> <u>400</u> (material) (depth) <u>4 1/2</u> if telescope see back. (size) (5) screen <u>20</u> <u>420-400</u> (length) (depth to top) <u>2</u> <u>PVC</u> (size) (material) (6) pump <u>1</u> <u>20</u> (HP) (yield gpm) <u>elect</u> (type power) (7) electric log _____ (yes or no) (organization running log) (8) how well bottom plugged <u>back wash</u>	Sand & gravel	60	91
	bitum shell	91	145
	Clay	145	195
	Clay St Banks	195	290
	Sand Grv.	290	320
	Sand, gravel	320	444
DRILLERS REMARKS:			

RECEIVED
JUN 29 1977

MISS. BD. OF WATER COMMISSIONERS

If well telescopes please sketch and show depths.

GROUND LEVEL

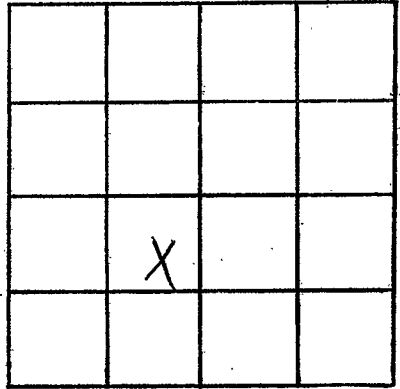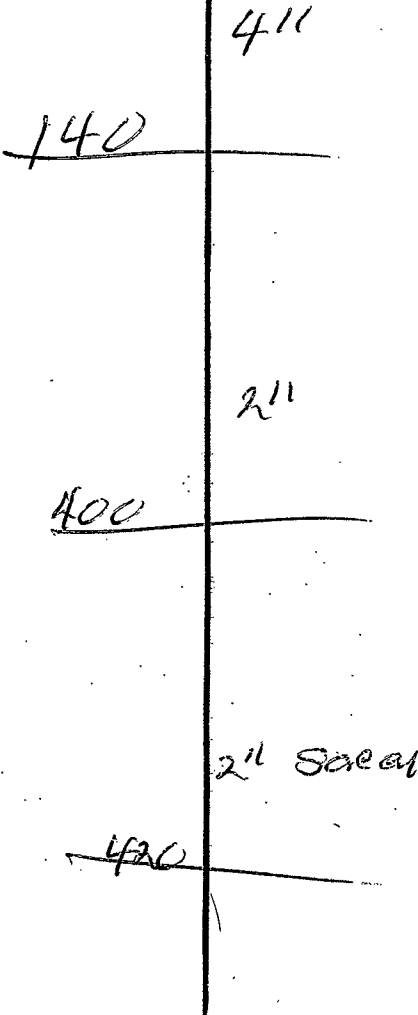

SECTION 33

Please indicate well location X.

ADDITIONAL INFORMATION

If more than one screen, show locations of each on sketch.