

WASHINGTON

D 1011

11-15-77

MISSISSIPPI BOARD OF WATER COMMISSIONERS

416 North State Street

151 Jackson, Mississippi 39201

WATER WELL DRILLERS LOG

11-15 date well completed

1976 Schultz Drilling firm name

Washington county well located

LANDOWNER: Furnace Tr R

description of formations encountered

from to

GREENVILLE Ms. (mailing address)

clay
sand

0 21
21 88

WELL LOCATION:

sec 25 T 18 N R 8 E
1 miles E of Greenville

sand shale
1 sand strata
SAND

88 386
386 488

WELL PURPOSE: for store
(home, irrigation, municipal, industrial)

WELL COMPLETION DATA:

- (1) diameter (inches) 4" x 3"
- (2) total depth (feet) 480'
- (3) static water level (feet) 4 below top of ground.
- (4) casing P.V.C (material), (depth) _____ (size) if telescope see back.
- (5) screen 30 (length), (depth to top) 3' (size), P.V.C (material)
- (6) pump 3 (HP), 75 (yield gpm)
ele (type power)
- (7) electric log (yes or no) _____

(organization running log)

(8) how well bottom plugged shut



DRILLERS REMARKS: Good Sand

RECEIVED JUN 7 1977

MISS. Bd OF WATER COMMISSIONERS

If well telescopes please sketch and show depths.

GROUND LEVEL

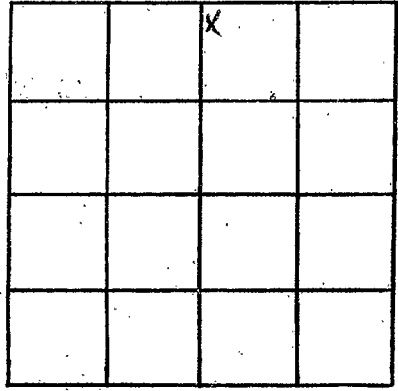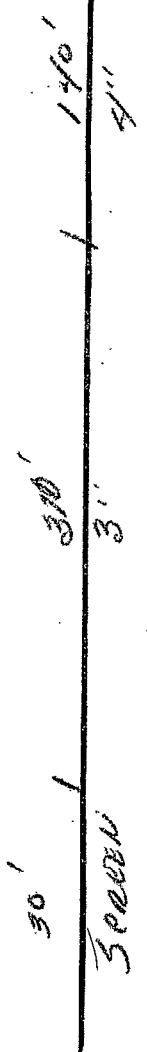

SECTION 25

Please indicate well location X.

ADDITIONAL INFORMATION

Lined area for additional information.

If more than one screen, show locations of each on sketch.