

WASHINGTON
D 1012

MISSISSIPPI
BOARD OF WATER COMMISSIONERS
416 North State Street
Jackson, Mississippi 39201

WATER WELL DRILLERS LOG

8 Feb 78 19 Lambert Dr. / Waga Wash. county well located
date well completed firm name

LANDOWNER:
H. Medtcalke
Greenville, Miss.
(mailing address)

WELL LOCATION:
sec 32 T 18 N R 9 E
8 W
1 miles S of Greenville
(distance) (direction) (nearest town)

description of formations encountered	from	to
Mixed	0	10
Sand	10	50
Sand & gravel	50	92
Clay	92	180
Clay & sand	180	250
sand	250	475

WELL PURPOSE: none
(home, irrigation, municipal, industrial)

WELL COMPLETION DATA:

(1) diameter (inches) 4x2

(2) total depth (feet) 400

(3) static water level (feet) 60 below top of ground.

(4) casing PVC, 380
(material) (depth)
4x2 if telescope see back.
(size)

(5) screen 20', 180-380
(length) (depth to top)
2" PVC
(size) (material)

(6) pump 1, 20
(HP) (yield gpm)
elect
(type power)

(7) electric log no.
(yes or no)
(organization running log)

(8) how well bottom plugged
back wash

RECEIVED
MAY 16 1978
MISS. BD. OF WATER COMMISSIONERS

DRILLERS REMARKS:

If well telescopes please sketch and show depths.

GROUND LEVEL

140


4''

380

2''

400

2'' 55

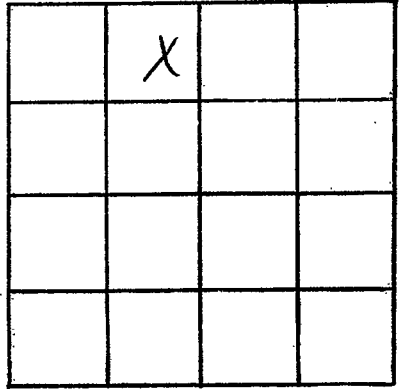

SECTION 32

Please indicate well location X.

ADDITIONAL INFORMATION

If more than one screen,
show locations of each on sketch.