

WASHINGTON

D 1013

8-1-78

MISSISSIPPI BOARD OF WATER COMMISSIONERS
416 North State Street
Jackson, Mississippi 39201

WATER WELL DRILLERS LOG

1 Aug date well completed 1978 Lambert Drilling firm name Wash county well located

LANDOWNER:
Jimmy Mc Daniels
Greenville, Miss.
(mailing address)

WELL LOCATION:
sec. 10 T. 18 N. R. 9 E
1 miles S.W. of Greenville
(distance) (direction) (nearest town)

WELL PURPOSE: WZMC
(home, irrigation, municipal, industrial)


- WELL COMPLETION DATA:
- (1) diameter (inches) 4 1/2
 - (2) total depth (feet) 460
 - (3) static water level (feet) 46 below top of ground.
 - (4) casing PVC, 440,
(material) (depth)
4 1/2 If telescope see back.
(size)
 - (5) screen 20, 460-440
(length) (depth to top)
2, PVC
(size) (material)
 - (6) pump 1 20
(HP) (yield gpm)
elect
(type power)
 - (7) electric log NO
(yes or no)

(organization running log)

(8) how well bottom plugged
back wash

DRILLERS REMARKS:

description of formations encountered	from to	
Mixed	0	10
Sand	10	60
gravel	60	96
Clay	96	205
Clay st Sand	205	310
Sand st Clay	310	400
Sand	400	470

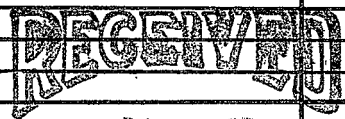

SEP - 8 1978

If well telescopes please sketch and show depths.

GROUND LEVEL

~~140~~ 4"

~~450~~ 2"

~~460~~ 2" SCR.

			X

SECTION 10

Please indicate well location X.

ADDITIONAL INFORMATION

If more than one screen, show locations of each on sketch.