

WASHINGTON  
 D 1014  
 5-2-78

MISSISSIPPI  
 BOARD OF WATER COMMISSIONERS  
 416 North State Street  
 Jackson, Mississippi 39201

WATER WELL DRILLERS LOG

2 miles date well completed      1978 Lombard Drilling firm name      WASH county well located

LANDOWNER:	description of formations encountered	from	to
(mailing address)			
<u>Johnny Harper,</u> <u>Greenville, Miss.</u>	<u>clay</u>	<u>0</u>	<u>30</u>
<u>WELL LOCATION:</u> sec. <u>33</u> T <u>18</u> N R <u>8</u> E S W <u>3</u> miles <u>S</u> of <u>Greenville</u> (distance) (direction) (nearest town)	<u>sand &amp; gravel</u>	<u>30</u>	<u>86</u>
<u>WELL PURPOSE:</u> <u>none</u> (home, irrigation, municipal, industrial)	<u>clay</u>	<u>86</u>	<u>180</u>
<u>WELL COMPLETION DATA:</u> (1) diameter (inches) <u>4x2</u> (2) total depth (feet) <u>400</u> (3) static water level (feet) <u>57</u> below/above top of ground. (4) casing <u>PVC</u> <u>380</u> (material) (depth) <u>4x2</u> if telescope see back. (size) (5) screen <u>20</u> <u>400-380</u> (length) (depth to top) <u>2 1/2</u> <u>PVC</u> (size) (material) (6) pump <u>1 1/2</u> <u>20</u> (HP) (yield gpm) <u>eled</u> (type power) (7) electric log <u>no</u> (yes or no) <u>(organization running log)</u> (8) how well bottom plugged, <u>back wash</u>	<u>clay &amp; sand</u>	<u>180</u>	<u>240</u>
<u>DRILLERS REMARKS:</u>	<u>sand, good</u>	<u>240</u>	<u>400</u>

RECEIVED  
 SEP - 8 1978

MISS. BD. OF WATER COMMISSIONERS


If well telescopes please sketch and show depths.

GROUND LEVEL

140 4<sup>th</sup>

380 2<sup>nd</sup>

400 2<sup>nd</sup> WS

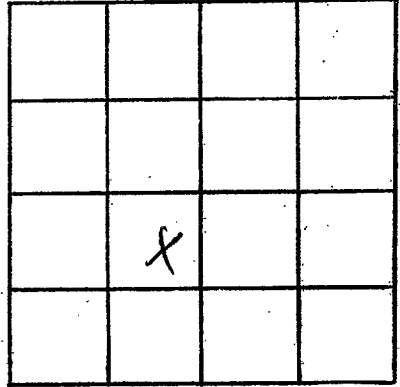

SECTION 33

Please indicate well location X.

ADDITIONAL INFORMATION

If more than one screen, show locations of each on sketch.