

Washington
D 1015

MISSISSIPPI
BOARD OF WATER COMMISSIONERS
416 North State Street
Jackson, Mississippi 39201

WATER WELL DRILLERS LOG

10/20/78

20 Oct
date well completed

1978 Lambert Dr 'D' Wash
firm name

Wash
county well located

LANDOWNER:	description of formations encountered	from	to
A. N. Hays Cleveland Rd. Greenville (mailing address)			
WELL LOCATION:	Sand	25	60
sec. 26 T 15 N R 8 E 8 W 4 miles S E of Greenville (distance) (direction) (nearest town)	Sand & gravel	60	96
WELL PURPOSE: none (home, irrigation, municipal, industrial)	Clay blue	96	210
WELL COMPLETION DATA:	Clay st sand	210	345
(1) diameter (inches) 2	Sand med.	345	370
(2) total depth (feet) 440	Sand good.	370	440
(3) static water level (feet) 48 below top of ground.			
(4) casing PVC, 430 (material) (depth)			
2 (size) if telescope see back.			
(5) screen 10, 480-430 (length) (depth to top)			
2, PVC (size) (material)			
(6) pump 1, 9 (HP) (yield gpm)			
elect (type power)			
(7) electric log NO (yes or no)			
(organization running log)			
(8) how well bottom plugged back press.			
DRILLERS REMARKS:			


Miss. Board of Water Comm.

APR 4 - 1979

RECEIVED

If well telescopes please sketch and show depths.

GROUND LEVEL

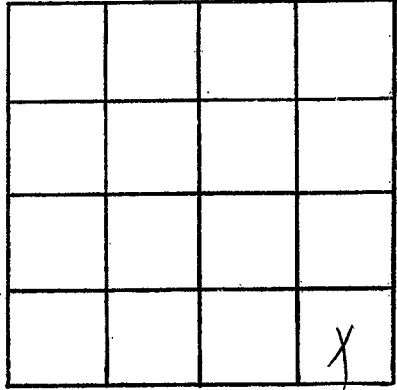

SECTION 26

Please indicate well location X.

ADDITIONAL INFORMATION

If more than one screen,
show locations of each on sketch.