

Wash.
 D 1016
 7-10-79

MISSISSIPPI
 BOARD OF WATER COMMISSIONERS
 416 North State Street
 Jackson, Mississippi 39201

WATER WELL DRILLERS LOG

10 Jan 1979 Lambert Drilling Wash.
 date well completed firm name county well located

LANDOWNER:	description of formations encountered	from	to
C Luke			
Lake Ferguson - Greenville (mailing address)	Mixed	0	10
WELL LOCATION:	Clay	10	30
sec. 8 T18 N R. SE W	Sand	30	60
3 miles N of Greenville (distance) (direction) (nearest town)	Sand & gravel	60	105
WELL PURPOSE: Home (home, irrigation, municipal, industrial)	Blue Shell	105	160
WELL COMPLETION DATA:	Clay	160	210
(1) diameter (inches) 2	Clay st sand	210	360
(2) total depth (feet) 460	Sand st clay	360	440
(3) static water level (feet) 58 below top of ground.	Sand gravel	390	440
(4) casing PVC 450 (material) (depth)			
2 (size) if telescope see back.			
(5) screen 20 450-460 (length) (depth to top)			
2 PVC (size) (material)			
(6) pump 1 9 (HP) (yield gpm)			
elect (type power)			
(7) electric log (yes or no)			
(organization running log)			
(8) how well bottom plugged back press.			
DRILLERS REMARKS:			


Miss. Board of Water Comm.

SEP 13 1979

RECEIVED

If well telescopes please sketch and show depths.

GROUND LEVEL

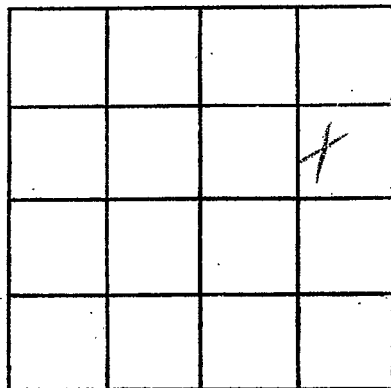

SECTION 3

Please indicate well location X.

ADDITIONAL INFORMATION

If more than one screen, show locations of each on sketch.