

Wash.
D 1017
6-10-79

MISSISSIPPI
 BOARD OF WATER COMMISSIONERS
 416 North State Street
 Jackson, Mississippi 39201

WATER WELL DRILLERS LOG

10 June 1979 Lambert Drilling Wash
 date well completed firm name county well located

LANDOWNER:	description of formations encountered	from	to
<u>Jonny Robinson</u>			
<u>Metcalfe Rd. Greenville</u> (mailing address)	<u>Clay</u>	<u>0</u>	<u>20</u>
WELL LOCATION: sec. <u>11</u> T. <u>18</u> N. R. <u>8</u> E. <u>3</u> miles <u>N</u> of <u>Greenville</u> (distance) (direction) (nearest town)	<u>Sand</u>	<u>20</u>	<u>60</u>
WELL PURPOSE: <u>name</u> (home, irrigation, municipal, industrial)	<u>Sand & gravel</u>	<u>60</u>	<u>110</u>
WELL COMPLETION DATA: (1) diameter (inches) <u>2</u>	<u>blue shell</u>	<u>110</u>	<u>180</u>
(2) total depth (feet) <u>460</u>	<u>Clay</u>	<u>180</u>	<u>240</u>
(3) static water level (feet) <u>49</u> below top of ground.	<u>Clay & soil</u>	<u>240</u>	<u>380</u>
(4) casing <u>PVC</u> , <u>450</u> , (material) (depth)	<u>Sand mud</u>	<u>380</u>	<u>440</u>
<u>2</u> if telescope see back. (size)	<u>Sand gravel</u>	<u>440</u>	<u>460</u>
(5) screen <u>10</u> , <u>460-450</u> (length) (depth to top)			
<u>2</u> , <u>PVC</u> (size) (material)			
(6) pump <u>1</u> <u>9</u> (HP) (yield gpm)			
<u>elect</u> (type power)			
(7) electric log _____ (yes or no)			
_____ (organization running log)			
(8) how well bottom plugged <u>each press.</u>			
DRILLERS REMARKS:			

Miss. Board of Water Comm.

SEP 18 1979


RECEIVED

If well telescopes please sketch and show depths.

GROUND LEVEL

0 30
 20 50
 40 70
 960 990
 980 1000

Dr. David

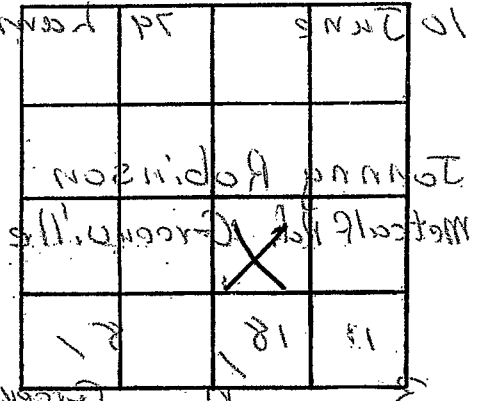

SECTION 11

Please indicate well location X.

ADDITIONAL INFORMATION

4
 480
 41
 120 300
 2
 10 480-420
 300 2
 1
 clect
 back here

If more than one screen, show locations of each on sketch.