

Wash.
~~4-16-79~~
 D 1018
 4-16-79

MISSISSIPPI
 BOARD OF WATER COMMISSIONERS
 416 North State Street
 Jackson, Mississippi 39201

WATER WELL DRILLERS LOG

16 Apr 1979 Lambert Drilling Co. Wash
 date well completed firm name county well located

LANDOWNER:	description of formations encountered	from	to
Sheet Sander's 82 W. Greenville, Miss. (mailing address)			
WELL LOCATION: sec. 32 T 18 N R 8 E 2 miles SSW of Greenville (distance) (direction) (nearest town)	Sand & gravel	15	65
WELL PURPOSE: none (home, irrigation, municipal, industrial)	Blue Shell	65	92
WELL COMPLETION DATA: (1) diameter (inches) 4x2 (2) total depth (feet) 400 (3) static water level (feet) 52 below top of ground. (4) casing PVC, 380 (material) (depth) 4x2 (size) if telescope see back. (5) screen 20, 400-380 (length) (depth to top) 2" PVC (size) (material) (6) pump 1 (HP), 20 (yield gpm) elect (type power) (7) electric log NO (yes or no) (organization running log) (8) how well bottom plugged back press	Clay st Sand	92	185
	Sand gravel	185	260
DRILLERS REMARKS:			

Miss. Board of Water Comm.

SEP 13 1979

RECEIVED


If well telescopes please sketch and show depths.

GROUND LEVEL

140 4 11

240 2 11

20 2" screen

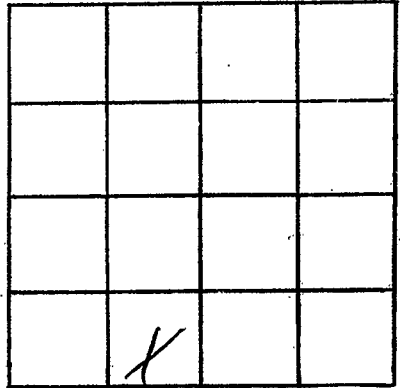

SECTION 32

Please indicate well location X.

ADDITIONAL INFORMATION

If more than one screen, show locations of each on sketch.