

Wash.  
D 1019  
7-24-79

MISSISSIPPI  
BOARD OF WATER COMMISSIONERS  
416 North State Street  
Jackson, Mississippi 39201

WATER WELL DRILLERS LOG

24 July 1979 Lambert Drilling Co Wash  
date well completed firm name county well located

LANDOWNER:	description of formations encountered	from	to
Johanna Mansauer Greenville, Miss. (mailing address)	Mixed	0	15
	Sand	15	60
WELL LOCATION: sec. 32 T 18 N R. 8 E 5 1/2 miles S of Greenville (distance) (direction) (nearest town)	Sand & gravel	60	82
	Clay	82	105
WELL PURPOSE: home (home, irrigation, municipal, industrial)	Shell blue	105	126
WELL COMPLETION DATA: (1) diameter (inches) 4 x 2 (2) total depth (feet) 345 (3) static water level (feet) 38 below top of ground. (4) casing PVC, 325 (material), (depth) 4 x 2 (size) if telescope see back. (5) screen 20, 345-325 (length), (depth to top) 2" (size), PVC (material) (6) pump 1 (HP), 20 (yield gpm) elect (type power) (7) electric log (yes or no) (organization running log) (8) how well bottom plugged back process.	Clay	126	240
	Sand, light	240	270
	Sand, good	270	350
DRILLERS REMARKS:			

DEPT. OF NATURAL RESOURCES  
BUREAU OF LAND & WATER RESOURCES

JAN 9 1980

RECEIVED


If well telescopes please sketch and show depths.

GROUND LEVEL

4" 140

2" 325

2" 345

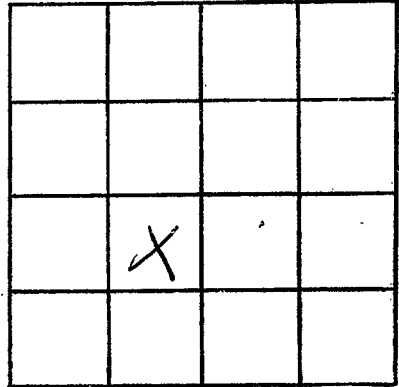

SECTION 36

Please indicate well location X.

ADDITIONAL INFORMATION

If more than one screen, show locations of each on sketch.