

WASHINGTON

D 1022

2-20-80

MISSISSIPPI BOARD OF WATER COMMISSIONERS
416 North State Street
Jackson, Mississippi 39201

WATER WELL DRILLERS LOG

20 Feb 1980
date well completed

Lambert Drilling Co.
firm name

Wash
county well located

LANDOWNER:
David Campbell
Greenville, Miss
(mailing address)

description of formations encountered	from	to
Mixed	0	5
Sand	5	75
Sand & gravel	75	90
Clay blue	90	170
Clay st Sand	170	315
Sand tight	315	330
Sand (good)	330	380

WELL LOCATION:
sec. 33 T 18 N R 8 E
8 W
3 1/2 miles S 60° of Greenville
(distance) (direction) (nearest town)

WELL PURPOSE: home
(home, irrigation, municipal, industrial)

- WELL COMPLETION DATA:
- (1) diameter (inches) 4x2
 - (2) total depth (feet) 380
 - (3) static water level (feet) 42 below top of ground.
 - (4) casing PVC, 370 (material) (depth)
4x2 (size) if telescope see back.
 - (5) screen 20, 380-360 (length) (depth to top)
2" PVC (size) (material)
 - (6) pump 3, 35 (HP) (yield gpm)
elect (type power)
 - (7) electric log (yes or no)
- (organization running log)
- (8) how well bottom plugged back press

DRILLERS REMARKS:

DEPT. OF NATURAL RESOURCES
BUREAU OF LAND & WATER RESOURCES

MAY 27 1980

RECEIVED


If well telescopes please sketch and show depths.

GROUND LEVEL

140 4''

360 2''

380 2'' sand.

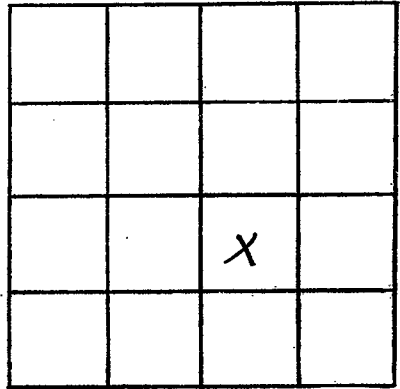

SECTION 33

Please indicate well location X.

ADDITIONAL INFORMATION

If more than one screen,
show locations of each on sketch.