

WASHINGTON

D 1023

5-18-80

MISSISSIPPI
 BOARD OF WATER COMMISSIONERS
 416 North State Street
 Jackson, Mississippi 39201

WATER WELL DRILLERS LOG

18 May 1980 Lambert Drilling Co Wash
 date well completed firm name county well located

LANDOWNER:	description of formations encountered	from	to
H. L. McCain Greenville, Miss (mailing address)			
WELL LOCATION: sec. 32 T 18 N R 8 E S W	Sand	15	60
2 miles SW of Greenville (distance) (direction) (nearest town)	Sand & gravel	60	93
WELL PURPOSE: home (home, irrigation, municipal, industrial)	Clay	93	150
WELL COMPLETION DATA:	Clay st sand	150	210
(1) diameter (inches) 4x2	Sand med	210	360
(2) total depth (feet) 480	Sand good	360	430
(3) static water level (feet) 41 below top of ground.			
(4) casing PVC, 420, (material) (depth) 4x2 (size) if telescope see back.			
(5) screen 10, 430-480 (length) (depth to top) 2" (size) SS (material)			
(6) pump 1, 20 (HP) (yield gpm) elect (type power)			
(7) electric log (yes or no)			
(organization running log)			
(8) how well bottom plugged back press			
DRILLERS REMARKS:			

DEPT. OF NATURAL RESOURCES
 BUREAU OF LAND & WATER RESOURCES

MAY 29 1980

RECEIVED


If well telescopes please sketch and show depths.

GROUND LEVEL

140 4''

420 2''

430 2'' 5CV.

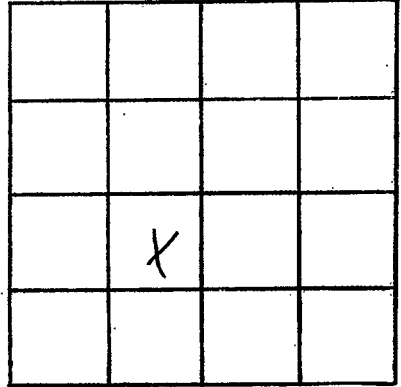

SECTION 32

Please indicate well location X.

ADDITIONAL INFORMATION

If more than one screen, show locations of each on sketch.