

MISSISSIPPI DEPARTMENT OF NATURAL RESOURCES

Bureau of Land and Water Resources

Southport Mall

P.O. Box 10631

Jackson, Mississippi 39209


WATER WELL DRILLERS LOG

WASHINGTON
D 1024
11-14-80

14 Nov 80 19 Lambert Drilling Co. Wash
date well completed firm name county well located

700
Set
32
w
94

LANDOWNER:	description of formations encountered	from	to
Keith Mitchel Crossmore Dr, Greenville, Miss. (mailing address)			
WELL LOCATION: sec. 32 T 18 N R 8 E W 1/2 miles S of Green (distance) (direction) (nearest town)	Sand	15	45
WELL PURPOSE: none (home, irrigation, municipal, industrial)	Sand & gravel	45	95
WELL COMPLETION DATA: (1) diameter (inches) 4x2	Clay blue	95	205
(2) total depth (feet) 525	Clay st sand	205	300
(3) static water level (feet) 46 below above top of ground.	Clay	300	316
(4) casing PVC 505 (material) (depth)	Clay st sand	316	380
4x2 (size) If telescope see back.	Sand st clay	380	455
(5) screen 20 525-505 (length) (depth to top)	Sand & gravel	455	465
2" PVC (size) (material)	Sand cov.	465	490
(6) pump 1 1/2 27 (HP) (yield gpm)		490	525
elect (type power)			
(7) electric log ne (yes or no) 4967			
(organization running log)			
(8) how well bottom plugged back press.			
DRILLERS REMARKS:			

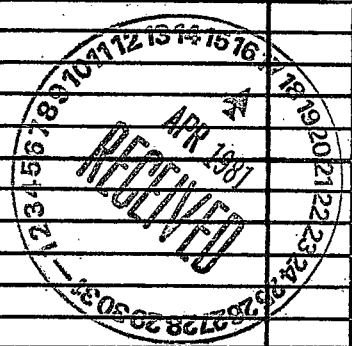

If well telescopes please sketch and show depths.

GROUND LEVEL

140 4"

505 2"

525 2" SCREEN

	X		

SECTION 32

Please indicate well location X.

ADDITIONAL INFORMATION

If more than one screen, show locations of each on sketch.