


WASHINGTON
D 1025
10-8-80

MISSISSIPPI
BOARD OF WATER COMMISSIONERS
416 North State Street
Jackson, Mississippi 39201

WATER WELL DRILLERS LOG

8 Oct 80 19 Lambert Drilling Wash
date well completed firm name county well located

LANDOWNER:	description of formations encountered	from	to
V.C. Hammatt 7 Oaks, Greenville, MS (mailing address)			
WELL LOCATION: sec. 15 T 18 N R 8 E 4 miles E of Greenville (distance) (direction) (nearest town)	Clay	0	35
WELL PURPOSE: Municipal (home, irrigation, municipal, industrial)	Sand	35	65
WELL COMPLETION DATA: (1) diameter (inches) 4x2	Sand & gravel	65	96
(2) total depth (feet) 450	Clay blue	96	260
(3) static water level (feet) 42 below top of ground.	Clay & sand	260	300
(4) casing PVC, 430 (material) (depth)	Sand med.	300	370
4x2 (size) if telescope see back.	Sand coar.	370	450
(5) screen 20, 450-430 (length) (depth to top)			
2, PVC (size) (material)			
(6) pump 2, 35 (HP) (yield gpm)			
elect (type power)			
(7) electric log (yes or no)			
(organization running log)			
(8) how well bottom plugged back press.			
DRILLERS REMARKS:			

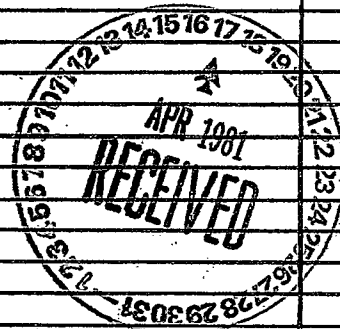


If well telescopes please sketch and show depths.

GROUND LEVEL

140 4"

430 2"

450 2" screen

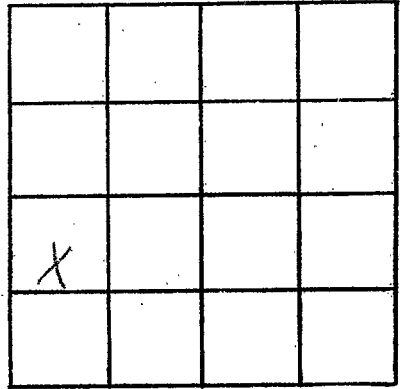

SECTION 15

Please indicate well location X.

ADDITIONAL INFORMATION

If more than one screen, show locations of each on sketch.