

MISSISSIPPI DEPARTMENT OF NATURAL RESOURCES

Bureau of Land and Water Resources

Southport Mall

P.O. Box 10631

Jackson, Mississippi 39209

WATER WELL DRILLERS LOG

WASHINGTON
D 1027
8/15/81

15 years date well completed 1981 Lambert Drilling firm name Wash county well located

LANDOWNER:	description of formations encountered	from	to
H.L. Watkins Greenville (mailing address)			
WELL LOCATION:	Sand	45	90
sec. 25 T 18 N R 8 E 2 1/2 E 1/4 S/4 of Greenville (distance) miles (direction) of (nearest town)	Blue Clay	90	210
WELL PURPOSE: Home (home, irrigation, municipal, industrial)	Clayst Sand	210	300
WELL COMPLETION DATA:	Gravel med	300	345
(1) diameter (inches) 4x2	Sand	345	380
(2) total depth (feet) 380			
(3) static water level (feet) 46 below top of ground.			
(4) casing PVC, 360 (material), (depth) 4x2 (size) if telescope see back.			
(5) screen 20 (length), 380-360 (depth to top) 2 (size), PVC (material)			
(6) pump 2 (HP), 35 (yield gpm) elect (type power)			
(7) electric log (yes or no) (organization running log)			
(8) how well bottom plugged back press			
DRILLERS REMARKS:			

DEPT. OF NATURAL RESOURCES
BUREAU OF LAND & WATER RESOURCES

NOV 20 1981
RECEIVED


If well telescopes please
sketch and show depths.

GROUND LEVEL

140 4"

360 2"

380 2" screen

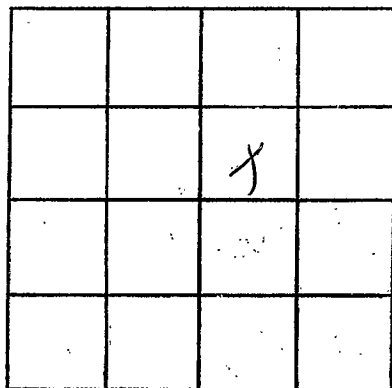

SECTION 25

Please indicate well location X.

ADDITIONAL INFORMATION

If more than one screen,
show locations of each on sketch.