

MISSISSIPPI DEPARTMENT OF NATURAL RESOURCES

Bureau of Land and Water Resources

Southport Mall

P.O. Box 10631

Jackson, Mississippi 39209

WATER WELL DRILLERS LOG

WASHINGTON
D 1028
8/23/81

23 Aug 1981 date well completed Lambert Drilling West firm name West county well located

LANDOWNER:	description of formations encountered	from	to
James Oliver,			
Creekmore Dr. (mailing address)	mixed	0	10
WELL LOCATION: sec. 33 T 18 N R 8 E 1 1/2 miles S/W of Green. (distance) (direction) (nearest town)	sand,	10	65
WELL PURPOSE: home (home, irrigation, municipal, industrial)	gravel	65	85
WELL COMPLETION DATA: (1) diameter (inches) 4x2 (2) total depth (feet) 470 (3) static water level (feet) 48 below top of ground. (4) casing PVC, 450. (material) (depth) 4x2 (size) if telescope see back. (5) screen 20, 470-450 (length) (depth to top) 2" (size), 85. (material) (6) pump 1/2, 28 (HP) (yield gpm) elect (type power) (7) electric log no. (yes or no) (organization running log) (8) how well bottom plugged back press	clay	85	220
	clay & sand,	220	380
	sand & fine	380	420
	sand.	420	450
DRILLERS REMARKS:			

DEPT. OF NATURAL RESOURCES
BUREAU OF LAND & WATER RESOURCES
SEP 16 1981
RECEIVED


If well telescopes please sketch and show depths.

GROUND LEVEL

140 4"

450 2"

470 2" S.C.

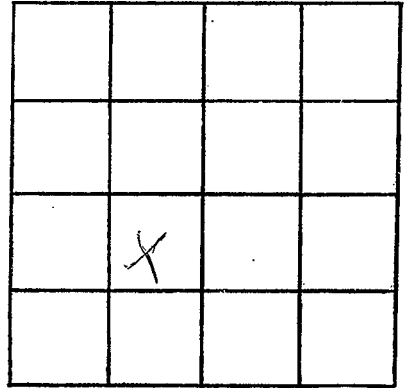

SECTION 33

Please indicate well location X.

ADDITIONAL INFORMATION

If more than one screen, show locations of each on sketch.