

MISSISSIPPI DEPARTMENT OF NATURAL RESOURCES

Bureau of Land and Water Resources

Southport Mall

P.O. Box 10631

Jackson, Mississippi 39209

WATER WELL DRILLERS LOG

Washington  
D 1029

18 Nov. 1981 Lambert Drilling Wash  
date well completed firm name county well located

LANDOWNER:	description of formations encountered	from	to
<u>C. Haito</u>			
<u>Lake Ferguson - Greenville</u> (mailing address)	<u>mixed</u>	<u>0</u>	<u>15</u>
<b>WELL LOCATION:</b>	<u>sand</u>	<u>15</u>	<u>75</u>
sec. <u>32</u> T. <u>18</u> N. R. <u>8</u> E. <u>W</u>	<u>sand &amp; gravel</u>	<u>75</u>	<u>108</u>
<u>3</u> miles <u>N.</u> of <u>Greenville</u> (distance) (direction) (nearest town)	<u>clay</u>	<u>108</u>	<u>210</u>
<b>WELL PURPOSE:</b> <u>home</u> (home, irrigation, municipal, industrial)	<u>rock</u>	<u>210</u>	<u>211</u>
<b>WELL COMPLETION DATA:</b>	<u>clay</u>	<u>211</u>	<u>270</u>
(1) diameter (inches) <u>4x2</u>	<u>rock</u>	<u>270</u>	<u>271</u>
(2) total depth (feet) <u>446</u>	<u>clay st sand</u>	<u>271</u>	<u>320</u>
(3) static water level (feet) <u>46</u> below above top of ground.	<u>sand st clay</u>	<u>320</u>	<u>360</u>
(4) casing <u>PVC</u> , <u>426</u> , (material) (depth)	<u>sand good</u>	<u>360</u>	<u>460</u>
<u>4x2</u> If telescope see back. (size)			
(5) screen <u>20</u> <u>446-426</u> (length) (depth to top)			
<u>2"</u> <u>PVC</u> (size) (material)			
(6) pump <u>1</u> <u>20</u> (HP) (yield gpm)			
<u>elect</u> (type power)			
(7) electric log <u>no</u> (yes or no)			
(organization running log)			
(8) how well bottom plugged <u>beck press</u>			

DEPT. OF NATURAL RESOURCES  
BUREAU OF LAND & WATER RESOURCES

FEB - 9 1982

RECEIVED

DRILLERS REMARKS:

If well telescopes please sketch and show depths.


GROUND LEVEL

4" 160

2" 426

2" Screen 446

If more than one screen, show locations of each on sketch.

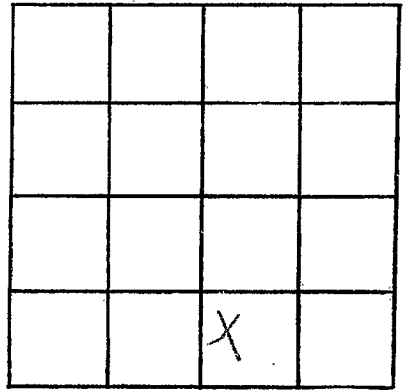

SECTION 32

Please indicate well location X.

ADDITIONAL INFORMATION

Multiple horizontal lines for additional information.