

MISSISSIPPI DEPARTMENT OF NATURAL RESOURCES

Bureau of Land and Water Resources

Southport Mall

P.O. Box 10631

Jackson, Mississippi 39209

WATER WELL DRILLERS LOG

Washington
D 1031

Hayes 1982 Lambert Drilling Wash
date well completed firm name county well located

LANDOWNER:	description of formations encountered	from	to
Mrs. Prime St. Christopher Rd. Greenville, Miss. (mailing address)			
WELL LOCATION:	Sand	20	70
sec. <u>19</u> T. <u>18</u> N. R. <u>8</u> E <u>5</u> miles ^S E of <u>Greenville</u> (distance) (direction) (nearest town)	pea gravel	70	85
WELL PURPOSE: <u>none</u> (home, irrigation, municipal, industrial)	Clay	85	205
WELL COMPLETION DATA:	Sand st Clay	205	405
(1) diameter (inches) <u>4 1/2</u>	Sand fine	405	435
(2) total depth (feet) <u>465</u>	Sand	435	465
(3) static water level (feet) <u>52</u> below above top of ground.			
(4) casing <u>PVC</u> , <u>445</u> (material) (depth)			
<u>4 1/2</u> if telescope see back. (size)			
(5) screen <u>20</u> , <u>465-445</u> (length) (depth to top)			
<u>2"</u> , <u>PVC</u> (size) (material)			
(6) pump <u>1</u> , <u>20</u> (HP) (yield gpm)			
<u>elect</u> (type power)			
(7) electric log (yes or no) _____			
(organization running log) _____			
(8) how well bottom plugged: <u>back 100%</u>			
DRILLERS REMARKS:			

DEPT. OF NATURAL RESOURCES
BUREAU OF LAND & WATER RESOURCES

SEP - 3 1982

RECEIVED


If well telescopes please sketch and show depths.

GROUND LEVEL

140 4''

445 2''

465 2' 50''

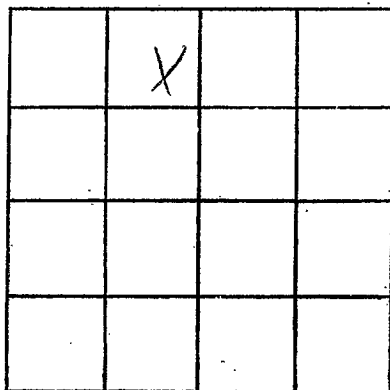

SECTION 19

Please indicate well location X.

ADDITIONAL INFORMATION

If more than one screen, show locations of each on sketch.