

MISSISSIPPI DEPARTMENT OF NATURAL RESOURCES

Bureau of Land and Water Resources

Southport Mall

P.O. Box 10631

Jackson, Mississippi 39209

WATER WELL DRILLERS LOG

Washington
D 1032

1982 date well completed Lambert Drilling Wash firm name county well located

LANDOWNER:	description of formations encountered	from	to
(mailing address)			
T. Hains, Greenville, Miss.	Clay	0	15
WELL LOCATION:	Sand	15	60
sec. 30 T 18 N R 8 E 8 miles S/E of Greenville (distance) (direction) (nearest town)	Dark gravel	60	90
WELL PURPOSE: <u>none</u> (home, irrigation, municipal, industrial)	blue clay	90	160
WELL COMPLETION DATA:	Clay + sand	160	320
(1) diameter (inches) <u>2"</u>	rock	320	321
(2) total depth (feet) <u>510</u>	Clay	321	335
(3) static water level (feet) <u>51</u> below above top of ground.	rock	335	336
(4) casing <u>PVC</u> , <u>500</u> , (material) (depth) <u>2"</u> (size) if telescope see back.	Clay	336	341
(5) screen <u>10</u> , <u>570-500</u> (length) (depth to top)	rock	341	342
<u>2"</u> , <u>PVC</u> (size) (material)	Sand + clay	342	480
(6) pump <u>1</u> , <u>10</u> (HP) (yield gpm)	Sand	480	510
<u>elect</u> (type power)			
(7) electric log <u>no</u> (yes or no)			
(organization running log)			
(8) how well bottom plugged <u>back press</u>			
DRILLERS REMARKS:			


DEPT. OF NATURAL RESOURCES
BUREAU OF LAND & WATER RESOURCES

SEP - 3 1982

RECEIVED

If well telescopes please sketch and show depths.

GROUND LEVEL

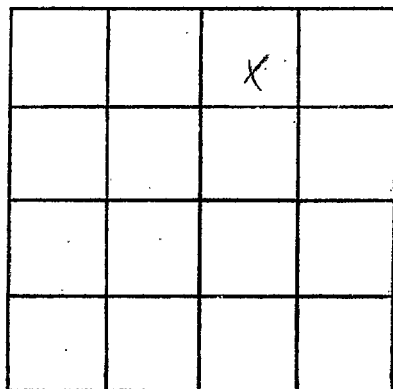

SECTION 30

Please indicate well location X.

ADDITIONAL INFORMATION

If more than one screen,
show locations of each on sketch.